


Give All Information Completely
Make Required Affidavit
Mail or Deliver Report to:
Conservation Division
State Corporation Commission
800 Biting Building
Wichita, Kansas

WELL PLUGGING RECORD

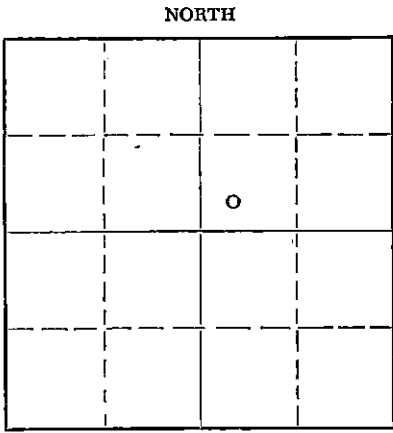

Locate well correctly on above
Section Plat

Pawnee County. Sec. 35 Twp. 22S Rge. 17 (~~EX~~ W (W))
Location as "NE/CNW/SW" or footage from lines. SW SW NE
Lease Owner Hilton Drilling Company, Inc.
Lease Name Redetzke Well No. 1
Office Address 2421 Tenth Street, Great Bend, Kansas
Character of Well (completed as Oil, Gas or Dry Hole) Dry Hole
Date well completed _____ 19____
Application for plugging filed July 21, 19 55
Application for plugging approved July 22, 19 55
Plugging commenced July 25, 19 55
Plugging completed July 26, 19 55
Reason for abandonment of well or producing formation Dry

If a producing well is abandoned, date of last production _____ 19____
Was permission obtained from the Conservation Division or its agents before plugging was commenced? Yes

Name of Conservation Agent who supervised plugging of this well W. H. Horner
Producing formation _____ Depth to top _____ Bottom _____ Total Depth of Well 4240 Feet
Show depth and thickness of all water, oil and gas formations.

OIL, GAS OR WATER RECORDS

CASING RECORD

FORMATION	CONTENT	FROM	TO	SIZE	PUT IN	PULLED OUT
		0	227	8-5/8"	227	None
			4238	5-1/2"	4238	3220.79

Describe in detail the manner in which the well was plugged, indicating where the mud fluid was placed and the method or methods used in introducing it into the hole. If cement or other plugs were used, state the character of same and depth placed, from _____ feet to _____ feet for each plug set.

Plugged back with sand to 4115, dumped in 5 sacks cement.
Plugged surface with pump truck; mixed and pumped in 20
sacks gel mud; put in plug; mixed and pumped in 100 sacks
cement.

(If additional description is necessary, use BACK of this sheet)
Name of Plugging Contractor Ace Pipe Pulling Company
Address Great Bend, Kansas.

STATE OF KANSAS, COUNTY OF BARTON, ss.
Henry Peacock, Secretary (employee of owner) or (owner or operator) of the above-described well, being first duly sworn on oath, says: That I have knowledge of the facts, statements, and matters herein contained and the log of the above-described well as filed and that the same are true and correct. So help me God.

(Signature) Henry Peacock
Henry Peacock, Secretary
Great Bend, Kansas
(Address)

SUBSCRIBED AND SWORN TO before me this 27th day of July 1955
Carmen Reinhardt Leiker
Carmen Reinhardt Leiker, Notary Public.

My commission expires January 26, 1959

24-7368-S 3-53-20M

PLUGGING
FILE SEC 35 T 22 R 17W
BOOK PAGE 136 LINE 26

RECEIVED
STATE CORPORATION COMMISSION
JUL 29 1955 7-28-55
CONSERVATION DIVISION
Wichita, Kansas

DRILLER'S LOG

COMPANY: Hilton Drilling Company, Inc. LOCATION: SW of SW of NE
 Section 35-22S-17W
 Pawnee County, Kansas
 CONTRACTOR: Hilton Drilling Company, Inc.
 FARM NAME: Redetzke #1 ELEVATION: 2050 D.F.
 COMMENCED: May 29, 1955 Casing Used: 8-5/8" @ 227' w/200 sxs.
 5-1/2" @4238' w/150 sxs.
 COMPLETED: June 11, 1955

Sand	40
Sand Gravel Clay	180
Blue Shale	227
Shale	340
Shale and Red Bed	540
Sand	615
Red Bed	1050
Anhydrite	1075
Shale, Shells and Salt	1375
Shale and Shells	1715
Shale and Lime	2165
Lime	2335
Shale and Lime	3040
Lime	3090
Shale and Lime	3195
Lime	3598
Shale and Lime	3708
Lime	3946
Shale and Lime	4123
Chert	4165
Cher, Lime and Shale	4240
Total Depth	4240

STATE OF KANSAS)
) SS.
 COUNTY OF BARTON)

I, the undersigned, being duly sworn on oath, state that the above statement and log are true and a correct record and log of the well drilled at the location above described.

HILTON DRILLING COMPANY, INC.

Henry Peacock
 Henry Peacock, Secretary

Subscribed and sworn to before me this 13th day of June, 1955:

My commission expires January 26, 1959

RECEIVED
 CORPORATION COMMISSION
 JUN 14 1955

Carman Reinhardt Luber
 Notary Public

REGISTRATION DIVISION
 Wichita, Kansas

PLUGGING
 FILE SEC 35 T 22 R 174
 BOOK PAGE 136 LINE 26