

WELL PLUGGING RECORD

15-075-10024-0000

Give All Information Completely  
Make Required Affidavit  
Mail or Deliver Report to:  
Conservation Division  
State Corporation Commission  
211 No. Broadway  
Wichita, Kansas

Hamilton County. Sec. 23 Twp. 21 Rge. 41W (E) (W)  
Location as "NE/CNW/SW" or footage from lines C-SE-NW

Lease Owner Livingston Oil Company

Lease Name Unit 2311 Well No. 1

Office Address Box 1797, Tulsa, Oklahoma

Character of Well (completed as Oil, Gas or Dry Hole) Dry Hole

Date well completed 1-18 19 63

Application for plugging filed 11-28 19 66

Application for plugging approved 12- 1 19 66


Plugging commenced 2- 18 19 67

Plugging completed 2- 20 19 67

Reason for abandonment of well or producing formation

If a producing well is abandoned, date of last production 19

Was permission obtained from the Conservation Division or its agents before plugging was commenced? Yes

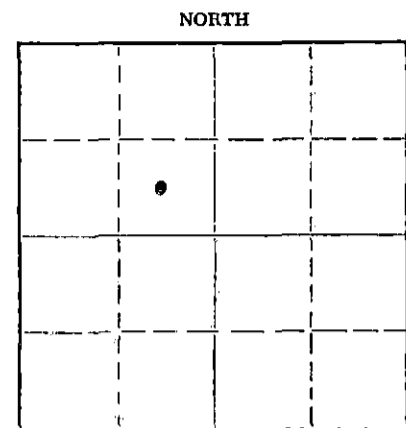

Locate well correctly on above Section Plot

Name of Conservation Agent who supervised plugging of this well Ed Eves

Producing formation Depth to top Bottom Total Depth of Well 2804 Feet

Show depth and thickness of all water, oil and gas formations.

OIL, GAS OR WATER RECORDS

CASING RECORD

FORMATION	CONTENT	FROM	TO	SIZE	PUT IN	PULLED OUT
				8 5/8	174	0
				4 1/2	2804	2508

Describe in detail the manner in which the well was plugged, indicating where the mud fluid was placed and the method or methods used in introducing it into the hole. If cement or other plugs were used, state the character of same and depth placed, from feet to feet for each plug set.

Mix 10 sacks cement with hulls to plug off bottom and stop plug at 2600 feet. Shoot pipe loose at 2508 and pull same to 600 feet. Spot 25 sacks cement at 600' to 525 feet. Mud to 175 and 15 sacks cement at 175 to 130 feet. mud 130 to 40 feet and 10 sacks cement at 40 ft to 0 feet.

RECEIVED  
STATE CORPORATION COMMISSION

MAR 13 1967  
03-13-67

CONSERVATION DIVISION  
Wichita, Kansas

(If additional description is necessary, use BACK of this sheet)  
Name of Plugging Contractor Sargent's Casing Pulling Service  
Address Box 506 Liberal, Kansas

STATE OF Oklahoma, COUNTY OF Tulsa, ss.  
Royd Phillips (employee of owner) or (owner or operator) of the above-described well, being first duly sworn on oath, says: That I have knowledge of the facts, statements, and matters herein contained and the log of the above-described well as filed and that the same are true and correct. So help me God.

(Signature) Royd Phillips

(Address)

SUBSCRIBED AND SWORN to before me this 10th day of March, 1967

My Commission Expires AUGUST 10, 1969  
Margaret Heath Notary Public.