

STATE OF KANSAS
STATE CORPORATION COMMISSION

Give All Information Completely
Make Required Affidavit
Mail or Deliver Report to:
Conservation Division
State Corporation Commission
211 No. Broadway
Wichita, Kansas

15.083.00079.00.00

WELL PLUGGING RECORD

Hodgeman County, Sec. 31 Twp. 22S Rge. 26 (W)

Location as "NE/CNWKSWK" or footage from lines C SW NW

Lease Owner Helmerich & Payne Inc. & B. E. Oil, Inc.

Lease Name CALLIS Well No. 1

Office Address First National Bank Bldg., Tulsa, Okla.

Character of Well (completed as Oil, Gas or Dry Hole) Dry Hole

Date well completed 4 January 19 62

Application for plugging filed 4 January 19 62

Application for plugging approved 4 January 19 62


Plugging commenced 4 January 19 62

Plugging completed 4 January 19 62

Reason for abandonment of well or producing formation Dry Hole

If a producing well is abandoned, date of last production _____ 19 _____

Was permission obtained from the Conservation Division or its agents before plugging was commenced? _____

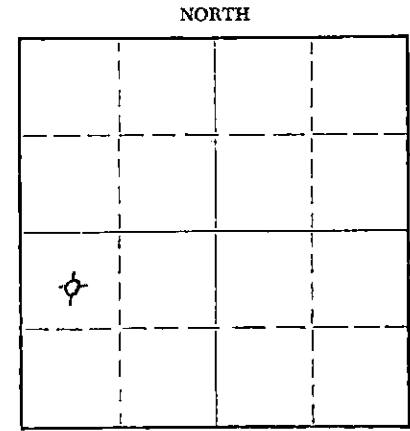

Locate well correctly on above Section Flat

Name of Conservation Agent who supervised plugging of this well W. L. Lackamp Jr. Stafford

Producing formation _____ Depth to top _____ Bottom _____ Total Depth of Well 4742 Feet

Show depth and thickness of all water, oil and gas formations.

OIL, GAS OR WATER RECORDS

CASING RECORD

FORMATION	CONTENT	FROM	TO	SIZE	PUT IN	PULLED OUT
		0	302	8-5/8"	302	None

Describe in detail the manner in which the well was plugged, indicating where the mud fluid was placed and the method or methods used in introducing it into the hole. If cement or other plugs were used, state the character of same and depth placed, from _____ feet to _____ feet for each plug set.

From: 4742 to 300 Heavy Rotary Mud
300 to 225 1/2 sack Hulls, Plug & 25 sacks Cement
225 to 40 Heavy Rotary Mud
40 to 4 1/2 sack Hulls, Plug & 10 sacks Cement
4 to Surface - Celler

Plugging Complete 10:00 AM 4 January 1962

1-11-62

STATE CORPORATION COMMISSION

JAN 11 1962

CONSERVATION DIVISION

(If additional description is necessary, use BACK of this sheet)

Name of Plugging Contractor Garvey Drilling Co.

Address 352 North Broadway, Wichita, Kansas

STATE OF Kansas, COUNTY OF Finney, ss.

T. E. Mort (employee of owner) or (~~owner~~) of the above-described

well, being first duly sworn on oath, says: That I have knowledge of the facts, statements, and matters herein contained and the log of the above-described well as filed and that the same are true and correct. So help me God.

(Signature) T. E. Mort

Box 255 Garden City, Kansas

(Address)

SUBSCRIBED AND SWORN TO before me this 8 day of January, 1962

Robert N. Boyd
Robert N. Boyd Notary Public.

My commission expires 1 July 1964



WELL LOG

15.083.00079.00.00

COMPANY HELMERICH & PAYNE

SEC. 31 T. 22S R. 26W

FARM HAROLD CALLIS NO. 1


LOC. C-SW, NW

TOTAL DEPTH 4743'

COUNTY HODGEMAN CO., KANSAS

COMM. December 16, 1961 COMP. January 4, 1962

CONTRACTOR GARVEY DRILLING COMPANY

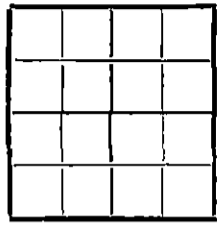

CASING 8-5/8" @ 302' w/250 sax.

ELEVATION 2614' DF

PRODUCTION D & A

FIGURES INDICATE BOTTOM OF FORMATIONS

55	Surface soil & sand
440	Shale
475	Sand
940	Shale
1180	Red bed
1206	Anhydrite
1970	Shale & shells
2305	Shale & lime
2462	Lime & shale
2716	Shale & lime
2983	Lime & shale
3063	Shale & lime
3253	Lime & shale
3490	Shale & lime
3640	Lime & shale
3720	Chalky lime
3870	Lime
3975	Lime & shale
4199	Lime
4255	Cherty lime
4296	Lime
4368	Shale & lime
4743	Lime
4743	T. D.

RECORDED
 STATE OF KANSAS COMMISSIONER
 FEB 2 1962
 CONSERVATION DIVISION

State of KANSAS }
 County of BARTON } ss

I, VERNE A. MORRIS of GARVEY DRILLING COMPANY

upon oath state the above and foregoing is a true and correct copy of the log of the #1 HAROLD CALLIS well.

Verne A. Morris

Subscribed and sworn to before me this 18th day of January 1962

My Commission Expires: November 12, 1962

Beaufort
 NOTARY PUBLIC