


WELL PLUGGING RECORD

Give All Information Completely
Make Required Affidavit
Mail or Deliver Report to:
Conservation Division
State Corporation Commission
211 No. Broadway
Wichita, Kansas

Hodgeman County, Sec. 33 Twp. 23S Rge. 21 (W)

Location as "NE/CNW/SW" or footage from lines G SW SE
Lease Owner Mallonee-Coppinger Operations, Inc.
Lease Name Mooney Well No. 1
Office Address 1207 Union National Building, Wichita
Character of Well (completed as Oil, Gas or Dry Hole) dry hole
Date well completed 9-20-66 19
Application for plugging filed 9-20-66 19
Application for plugging approved 9-20-66 19
Plugging commenced 9-20-66 19
Plugging completed 9-20-66 19
Reason for abandonment of well or producing formation -

NORTH

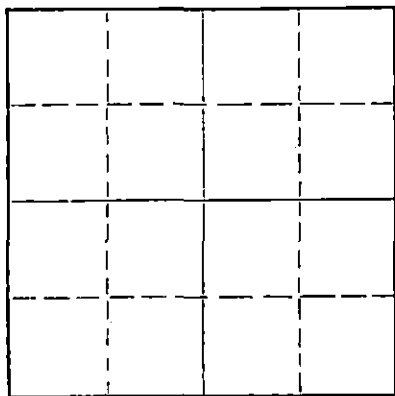

Locate well correctly on above
Section Plat

If a producing well is abandoned, date of last production - 19
Was permission obtained from the Conservation Division or its agents before plugging was commenced? yes

Name of Conservation Agent who supervised plugging of this well Ed Edes, Sublette, Kansas
Producing formation _____ Depth to top _____ Bottom _____ Total Depth of Well 4756 Feet
Show depth and thickness of all water, oil and gas formations.

OIL, GAS OR WATER RECORDS

CASING RECORD

FORMATION	CONTENT	FROM	TO	SIZE	PUT IN	PULLED OUT
				8-5/8"	271	NONE

Describe in detail the manner in which the well was plugged, indicating where the mud fluid was placed and the method or methods used in introducing it into the hole. If cement or other plugs were used, state the character of same and depth placed, from _____ feet to _____ feet for each plug set.

4756 - 700 - Heavy rotary mud
700 - HB plug, 35 sacks cement
700 - 320 - Heavy rotary mud
320 - HB plug, 30 sacks cement, 1/2 sack hulls
320 45 - Heavy rotary mud
45 - GL - HB plug, 10 sacks cement, 1/2 sack hulls

RECEIVED
STATE CORPORATION COMMISSION

SEP 28 1966

9-28-66

(If additional description is necessary, use BACK of this sheet)
Name of Plugging Contractor Peel Brothers, Inc.
Address Box 359, Hoisington, Kansas

STATE OF Kansas, COUNTY OF Barton, ss.
Peel Brothers, Inc. (employee of owner) or (owner or operator) of the above-described well, being first duly sworn on oath, says: That I have knowledge of the facts, statements, and matters herein contained and the log of the above-described well as filed and that the same are true and correct. So help me God.

(Signature) Jack Mattocks
W. E. "Jack" Mattocks
Drilling Superintendent

SUBSCRIBED AND SWORN TO before me this 22nd day of September, 19 66

My commission expires 6-21-70
Ethel S. Williamson
Notary Public.

shirley
s c c

15.083.30096.00.00

DRILLING LOG

LEASE OWNER Mallonee-Coppinger Operations, Inc ADDRESS 1207 Union National Bldg
Wichita, Kansas
LEASE Warden #1 COUNTY Seward, Kansas DESCRIPTION Sec. 30-34S-32W

CASING: SIZE 8 5/8 WEIGHT 123 lb AMOUNT 1298'
CEMENT: AMOUNT 750 Sx. CIRCULATED: Yes X No _____

CASING: SIZE 4 1/2 WEIGHT 10.5 AMOUNT 5359 KB
CEMENT: AMOUNT 150 Sx. CIRCULATED: Yes X No _____

PLUG SET: _____ Ft. TO _____ Ft. CEMENT _____ Sx.
_____ Ft. TO _____ Ft. CEMENT _____ Sx.

FORMATION AND DEPTH


Surface Sand	0	TO	590
Red Bed	590	TO	640
Red Bed & Sand	640	TO	1198
Red Bed	1198	TO	1299
Shale & Anhydrite-Red Bed	1299	TO	1723
Red Bed & Shale	1723	TO	2120
Red Bed, Shale, Anhydrite	2120	TO	2566
Lime & Shale	2566	TO	3246
Lime, Shale, Chalk	3246	TO	3415
Lime & Shale	3415	TO	4778
Lime	4778	TO	5433
Lime & Shale	5433	TO	6367
Lime	6367	TO	6560
TD	6560	TO	

THIS IS A TRUE AND EXACT COPY OF THE FORMATIONS TAKEN FROM THE DAILY DRILLING REPORTS.

Executed this 26th day of September 19 66

By T. W. Mahoney

IN WITNESS WHEREOF, I have hereunto set my hand and affixed my official seal the day and year above written.

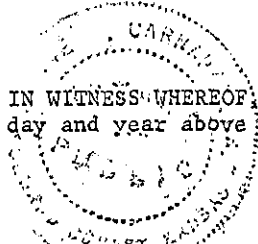

George W. Casadant
Notary Public

MY COMMISSION EXPIRES: January 24, 1968

RECEIVED
STATE CORP. REGISTRATION DIVISION

SEP 28 1966

[Signature]

15.083.30096.00.00

DRILLER'S LOG

Well Owner: Mallonee-Coppinger Operations, Inc.
Farm Name: Mooney No. 1
Date Started: September 8, 1966
Date Completed: September 20, 1966
Total Depth: 4756'

C SW SE
Section 33-23S-21W
Hodgeman County, Kansas

Casing: 8-5/8" set at 271' cemented

Contractor: Feel Brothers, Inc.

Figures below are the bottoms of formations:

Clay and Sand	0 - 110
Sand	1045
Shale and Shells	1443
Anhydrite	1470
Shale	2090
Shale and Lime	3295
Lime and Shale	3900
Lime	4635
Lime and Chert	4756
Total Depth	4756

This is to certify that the above information is to the best of our knowledge true and correct.

FEEL BROTHERS, INC.

Jack Mattocks
W. E. "Jack" Mattocks
Drilling Superintendent

SUBSCRIBED AND SWORN to before me this 22nd day of September, 1966.

Ethel S. Williamson
Ethel S. Williamson
Notary Public

My Commission expires 6-21-70

RECEIVED
NOTARY PUBLIC COMMISSION

SEP 28 1966

NOTARY PUBLIC