


15,083.0026400.00
WELL PLUGGING RECORD

All Information Completely
Make Required Affidavit
Mail or Deliver Report to:
Conservation Division
State Corporation Commission
211 No. Broadway
Wichita, Kansas

Hodgeman County, Sec. 33 Twp. 23S Rge. 21W (E) (W)
Location as "NE/CNWSW" or footage from lines C/NE NW
Lease Owner Don C. Slawson
Lease Name SEIDL "A" Well No. One
Office Address Suite 408 One Twenty Building - Wichita 2, Kansas
Character of Well (completed as Oil, Gas or Dry Hole) Dry Hole
Date well completed January 1, 1964 19
Application for plugging filed January 2, 1964 19
Application for plugging approved January 2, 1964 19
Plugging commenced January 2, 1964 19
Plugging completed January 2, 1964 19
Reason for abandonment of well or producing formation Dry Hole

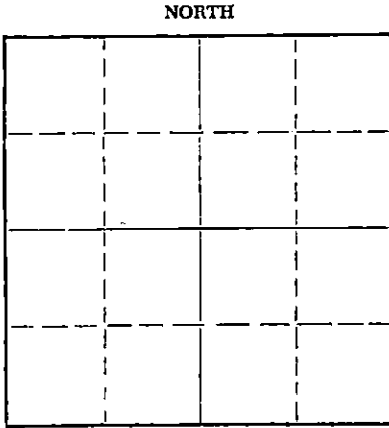

Locate well correctly on above
Section Flat

If a producing well is abandoned, date of last production 19
Was permission obtained from the Conservation Division or its agents before plugging was commenced? Yes

Name of Conservation Agent who supervised plugging of this well A. Elving - Post Office Box 248 - Pratt, Kansas
Producing formation Depth to top Bottom Total Depth of Well 4770 Feet
Show depth and thickness of all water, oil and gas formations.

OIL, GAS OR WATER RECORDS

CASING RECORD

FORMATION	CONTENT	FROM	TO	SIZE	PUT IN	PULLED OUT
				8 5/8"	206'	None

Describe in detail the manner in which the well was plugged, indicating where the mud fluid was placed and the method or methods used in introducing it into the hole. If cement or other plugs were used, state the character of same and depth placed, from feet to feet for each plug set.

Plugged with 25 sacks cement @ 700', with 25 sacks cement @ 200', with 10 sacks cement @ 40', and with 25 sacks cement in rat hole.

1-13-64

RECEIVED
STATE CORPORATION COMMISSION

JAN 13 1964

CONSERVATION DIVISION
Wichita, Kansas

(If additional description is necessary, use BACK of this sheet)

Name of Plugging Contractor Murfin Drilling Company
Address 617 Union Center Building - Wichita 2, Kansas

STATE OF Kansas, COUNTY OF Sedgwick, ss.
I, C. Robert Buford (employee of owner or (owner or operator) of the above-described well, being first duly sworn on oath, says: That I have knowledge of the facts, statements, and matters herein contained and the log of the above-described well as filed and that the same are true and correct. So help me God.

(Signature) C. Robert Buford
Murfin Drilling Company - 617 Union Center Bldg.
(Address) Wichita 2, Kansas

SUBSCRIBED AND SWORN to before me this 8th day of January, 1964

Mary Ruth Blume
Notary Public.

My commission expires June 14, 1964

WELL LOG


15.083.00264.00.00

COMPANY Don C. Blawson
FARM SEIDL "A" NO. One

SEC. 33 T. 23S R. 21W
LOC. C/NE NW

RIG. NO. 12
TOTAL DEPTH 4770'
COMM. 12/18/63 COMP. 1/2/64
SHOT OR TREATED No
CONTRACTOR Murfin Drilling Company
ISSUED

COUNTRY Hodgeman
KANSAS

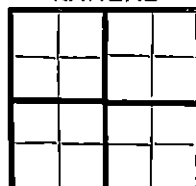

CASINO

20 10
15 8 5/8" 226' with 200 sacks cement
12 6
13 5

ELEVATION

PRODUCTION D & A

FIGURES INDICATE BOTTOM OF FORMATIONS

- 70' Clay and Shale
- 90' Sand
- 215' Blue Shale
- 345' Sand
- 950' Red Bed and Shale
- 1140' Sand
- 1475' Shale - Shells
- 1495' Anhydrite
- 1915' Shale and Shells
- 2295' Shale
- 2360' Lime
- 2545' Lime - Shale
- 2705' Shale and Lime
- 2920' Lime - Shale
- 3135' Lime
- 3370' Lime - Shale
- 3472' Shale and Lime
- 3550' Lime
- 3730' Lime - Shale
- 3835' Shale and Lime
- 3975' Lime and Shale
- 4005' Lime
- 4020' Lime - Shale
- 4100' Shale and Lime
- 4310' Lime
- 4395' Lime - Shale
- 4489' Lime
- 4525' Lime - Shale
- 4629' Lime
- 4660' Lime - Shale
- 4680' Lime
- 4770' Chert

RECEIVED
STATE CORPORATION COMMISSION

JAN 13 1964

CONSERVATION DIVISION
Wichita, Kansas

State of Kansas
County of Sedgwick } ss:

I, C. Robert Buford of the Murfin Drilling Company

upon oath state that the above and foregoing is a true and correct copy of the log of the SEIDL "A" #1 well.

C. Robert Buford

Subscribed and sworn to before me this 8th day of January 19 64

My Commission Expires: June 14, 1964

Mary Ellen Blum
NOTARY PUBLIC