

STATE OF KANSAS  
STATE CORPORATION COMMISSION

Give All Information Completely  
Make Required Affidavit  
File or Deliver Report to:  
Conservation Division  
State Corporation Commission  
212 North Market, Insurance Bldg.  
Wichita, Kansas

15.083.000/9.00.00  
WELL PLUGGING RECORD

Hodgeman County, Sec. 29 Twp. 23 Rge. 22 ~~XX~~ (W)

Location as "NE/CNW/SW" or footage from lines C NW NW

Lease Owner Kenneth Rupp and Prime Drilling Company

Lease Name Sebes Well No. 1

Office Address 814 Union Center, Wichita, Kansas

Character of Well (completed as Oil, Gas or Dry Hole) Dry Hole

Date well completed July 24 19 61

Application for plugging filed July 24 19 61

Application for plugging approved July 24 19 61


Plugging commenced July 24 19 61

Plugging completed July 24 19 61

Reason for abandonment of well or producing formation no oil and/or gas found in commercial quantities

If a producing well is abandoned, date of last production 19

Was permission obtained from the Conservation Division or its agents before plugging was commenced? yes

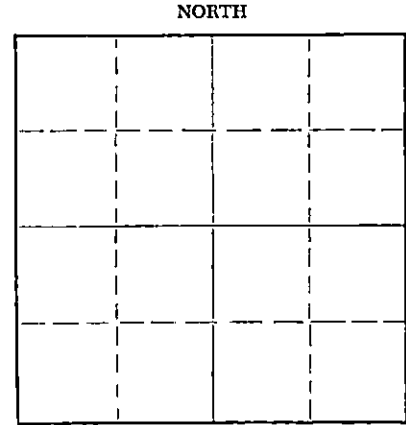

Locate well correctly on above Section Plat

Name of Conservation Agent who supervised plugging of this well Frank Broadfoot,

Producing formation \_\_\_\_\_ Depth to top \_\_\_\_\_ Bottom \_\_\_\_\_ Total Depth of Well 4820 Feet

Show depth and thickness of all water, oil and gas formations.

OIL, GAS OR WATER RECORDS

CASING RECORD

FORMATION	CONTENT	FROM	TO	SIZE	PUT IN	PULLED OUT
				8-5/8"	249'	none

Describe in detail the manner in which the well was plugged, indicating where the mud fluid was placed and the method or methods used in introducing it into the hole. If cement or other plugs were used, state the character of same and depth placed, from \_\_\_\_\_ feet to \_\_\_\_\_ feet for each plug set.

Filled hole with extra heavy rotary mud from total depth to 230'.  
Set Plug #1 at 230' with 20 sacks cement, 1/2 sacks Hulls. Filled hole with extra heavy rotary mud from Plug #1 to 35'. Set Plug #2 at 35' with 10 sacks cement, 1/2 sacks Hulls.

RECEIVED  
STATE CORPORATION COMMISSION

JUL 27 1961

CONSERVATION DIVISION  
Wichita, Kansas

(If additional description is necessary, use BACK of this sheet)

Name of Plugging Contractor Prime Drilling Company

Address 814 Union Center, Wichita, Kansas

STATE OF Kansas, COUNTY OF Sedgwick, ss.

R. R. McNicol (employee of owner) or (owner or operator) of the above-described well, being first duly sworn on oath, says: That I have knowledge of the facts, statements, and matters herein contained and the log of the above-described well as filed and that the same are true and correct. So help me God.

(Signature) R. R. McNicol

814 Union Center, Wichita, Kansas  
(Address)

SUBSCRIBED AND SWORN TO before me this 26th day of July, 1961

Darlene May

Notary Public.

My commission expires Sept. 30, 1963



15.083.000.19.00.00

ROTARY DRILLING LOG

OPERATOR: Rupp and Prime Drilling Company  
SEBES NO. 1  
C NW NW Sec. 29-23-22W,  
Hodgeman County, Kansas

CONTRACTOR: Prime Drilling Company  
COMM: 7-8-61  
COMP: 7-24-61

Remarks: Set 8-5/8" surface casing  
at 249' cemented with 180  
sacks cement

Formations:

Clay & Sand	90'
Shale	565'
Red Bed	620'
Shale & Sand	1260'
Shale	1505'
Shale & Lime	1760'
Shale & Shell	1930'
Shale	2200'
Shale & Lime	2600'
Lime	2670'
Lime & Shale	2780'
Shale & Lime	2880'
Lime & Shale	3120'
Shale & Lime	3230'
Lime & Shale	4008'
Lime	4579'
Lime & Chert	4597'
Cherty Lime	4620'
Lime	4694'
Lime & Chert	4768'
Lime	4820'
Rotary Total Depth (D&A)	4820'

RECEIVED  
STATE CORPORATION COMMISSION

JUL 27 1961

CONSERVATION DIVISION  
Wichita, Kansas

We certify the above log is true and  
correct to the best of our knowledge and  
belief.

PRIME DRILLING COMPANY

*R.R. McNicol*

R. R. McNicol

Subscribed to before me this 26th day of July, 1961.

My Commission Expires:  
Sept. 30, 1963

*Darlene May*  
Darlene May - Notary Public