

15.083.20433.00.00

FORM CP-4

STATE OF KANSAS
STATE CORPORATION COMMISSION
CONSERVATION DIVISION
P. O. BOX 17027
WICHITA, KANSAS 67217

WELL PLUGGING RECORD

Hodgman County, Sec. 33 Twp. 23 Rge. 23W (E) (W)

Location as "NE/CNW/SW" or footage from lines: E/2 W/2 NW/4

Lease Owner: Chief Drilling Company

Lease Name: Lappin #1 Well No. _____

Office Address: Wichita, Kansas 67202

Character of Well (completed as Oil, Gas or Dry Hole) _____

Date well completed _____ 19__

Application for plugging filed _____ 19__

Application for plugging approved _____ 19__


Plugging commenced 10/21/75 _____ 19__

Plugging completed 10/25/75 _____ 19__

Reason for abandonment of well or producing formation depleted.

If a producing well is abandoned, date of last production _____ 19__

Was permission obtained from the Conservation Division or its agents before plugging was commenced? yes

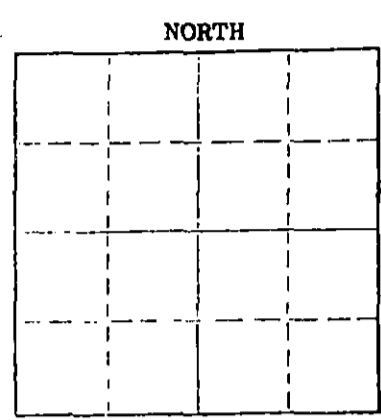

Locate well correctly on above Section Plat

Name of Conservation Agent who supervised plugging of this well Massey

Producing formation _____ Depth to top _____ Bottom _____ Total Depth of Well 4660 Feet

Show depth and thickness of all water, oil and gas formations. 4676

OIL, GAS OR WATER RECORDS

CASING RECORD

FORMATION	CONTENT	FROM	TO	SIZE	PUT IN	PULLED OUT
				8-5/8	350	none
				4 1/2	4653	2523'

Describe in detail the manner in which the well was plugged, indicating where the mud fluid was placed and the method or methods used in introducing it into the hole. If cement or other plugs were used, state the character of same and depth placed, from _____ feet to _____ feet for each plug set.

Checked hole, ran sand to 4600' and dumped 3 sacks cement.
 Loaded hole, shot pipe at 3921', 3624', 2480', 3234', 3035',
 2840', 2742', 2644', 2546', pulled 78 joints. Plugged well
 with 3 sacks hulls, 27 sacks gel and 100 sacks 50-50 pos cement,
 6% gel.

PLUGGING COMPLETE.

Name of Plugging Contractor KELSO CASING PULLING
 Address CHASE, KANSAS

STATE OF KANSAS COUNTY OF RICE, ss.
R. DARRELL KELSO (employee of owner) or (owner or operator) of the above-described

well, being first duly sworn on oath, says: That I have knowledge of the facts, statements, and matters herein contained and the log of the above-described well as filed and that the same are true and correct. So help me God.

(Signature) R. Darrell Kelso
CHASE, KANSAS (Address)

Subscribed and sworn to before me this 27th day of October, 19 75

My commission expires _____

 MARGARET MELCHER
 Rice County, Ks.
 My Comm. Exp. Feb. 15, 1979

Margaret Melcher
Notary Public.

RECEIVED
 STATE CORPORATION COMMISSION
 OCT 28 1975
 10-28-1975
 CONSERVATION DIVISION
 Wichita, Kansas

CHIEF DRILLING CO., INC.
 905 Century Plaza
 Wichita, Kansas 67202

LAPPIN #1
 E/2 W/2 NW Sec. 33-23S-23W
 Hodgeman County, Kansas

CONTRACTOR: Chief Drilling Co., Inc.
 CASING RECORD: 325' used 28# 8 5/8" set @ 331',
 ? cemented w/225 sacks common quick set.
 Plug down @ 6:00 P.M.

COMMENCED: 9/13/75
 COMPLETED: 9/24/75

FORMATION	FROM	TO
Sand & Shale	0	327
Sand, Clay & Shale	327	1201
Sand & Shale	1201	1832
Shale	1832	2150
Shale & Lime	2150	2614
Lime & Shale	2614	2733
Lime	2733	4660

ELEVATIONS

2397 Gr.
2399 D.F.
2402 K.B.

FORMATION TOPS

Anhydrite	1546 + 856
Base Anhy.	1567 + 835
Heebner	3936 - 1534
Toronto	3956 - 1554
Lansing	4000 - 1598
Base K.C.	4398 - 1996
Pawnee	4506 - 2104
Base Pawnee	4538 - 2136
Ft. Scott	4547 - 2145
Base Cher.	4621 - 2219
Miss. Dolo.	4637 - 2235
RTD	4660 - 2258

SEP 26 1975

STATE OF KANSAS, COUNTY OF SEDGWICK) ss:

I hereby certify that the above is a true and correct copy of the Driller's Log of the well drilled in the E/2 W/2 NW of Section 33-23S-23W, Hodgeman County, Kansas, to the best of my knowledge and belief.

CHIEF DRILLING CO., INC.

Jim Robinson
 Jim Robinson, Vice-President

Subscribed and sworn to before me this 25th day of September, 1975.

MARILYN SINARD
 STATE NOTARY PUBLIC
 SEDGWICK COUNTY, KANSAS
 MY COMM. EXP. APR. 30, 1979

Marilyn Sinard
 Marilyn Sinard - Notary Public