


15.083.10343.00.00

Give All Information Completely
Make Required Affidavit
Mail or Deliver Report to:
Conservation Division
State Corporation Commission
211 No. Broadway
Wichita, Kansas

WELL PLUGGING RECORD

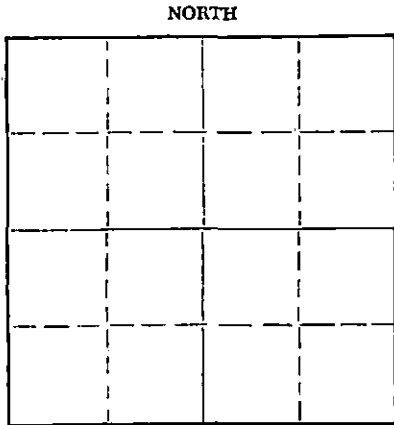

Locate well correctly on above
Section Plat

Hodgeman County. Sec. 23 Twp. 23S Rge. (E) 23 (W)
Location as "NE/CNW%SW%" or footage from lines 150' E Ctr NW NW
Lease Owner Texaco Inc.
Lease Name E. F. Lippoldt "D" Well No. 1
Office Address 614 Bitting Bldg., Wichita, Kansas
Character of Well (completed as Oil, Gas or Dry Hole) Dry Hole
Date well completed 6-21-19 64
Application for plugging filed 7-22-19 64
Application for plugging approved 7-24-19 64
Plugging commenced 8-13-19 64
Plugging completed 8-15-19 64
Reason for abandonment of well or producing formation Dry Hole

If a producing well is abandoned, date of last production None 19__
Was permission obtained from the Conservation Division or its agents before plugging was commenced? Yes

Name of Conservation Agent who supervised plugging of this well Hugh Scott, Sublette, Kansas
Producing formation None Depth to top _____ Bottom _____ Total Depth of Well 4652 Feet
Show depth and thickness of all water, oil and gas formations.

OIL, GAS OR WATER RECORDS

CASING RECORD

FORMATION	CONTENT	FROM	TO	SIZE	PUT IN	PULLED OUT
Dry Hole				8-5/8"	253'	None
				4-1/2"	4584'	3612'

Describe in detail the manner in which the well was plugged, indicating where the mud fluid was placed and the method or methods used in introducing it into the hole. If cement or other plugs were used, state the character of same and depth placed, from _____ feet to _____ feet for each plug set.

Hole plugged as follows: 4642-4575 w/sd
4575-4300 w/cmt
4300-660 w/mud
660-575 w/cmt
575-240 w/mud
240-175 w/cmt
175-35 w/mud
35-5 w/cmt
5-0'w/clay

RECEIVED
STATE CORPORATION COMMISSION

AUG 25 1964

CONSERVATION DIVISION
Wichita, Kansas

(If additional description is necessary, use BACK of this sheet)
Name of Plugging Contractor Knight Casing Pulling
Address Box 405, Chase, Kansas

STATE OF Kansas, COUNTY OF Sedgwick, ss.
H. N. Wade

(employee of owner) ~~BY OWNER OR OPERATOR~~ of the above-described well, being first duly sworn on oath, says: That I have knowledge of the facts, statements, and matters herein contained and the log of the above-described well as filed and that the same are true and correct. So help me God.

(Signature)

H. N. Wade
614 Bitting Bldg., Wichita, Kansas
(Address)

SUBSCRIBED AND SWORN TO before me this 20th day of August, 19 64

A. E. Boyd
Notary Public.

My commission expires 6-20-68

WELL LOG

15.083.10343.00.00

COMPANY **Texaco, Inc.**

SEC. **23 T. 23S R. 23W**

FARM **Lippoldt**

NO. **D-1**

LOC. **NW NW**


TOTAL DEPTH **4625'**

COUNTY **Hodgeman**

COMM. **5-9-64**

COMP. **5-25-64**

CONTRACTOR **Garvey Drilling Company**

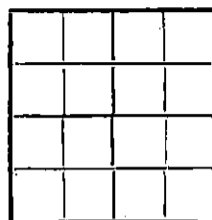

CASING **8 5/8" @ 254' w/175 sx**

4 1/2" @ 4584' w/100 sx

ELEVATION **2348' DF**

PRODUCTION

FIGURES INDICATE BOTTOM OF FORMATIONS

254' Blue Shale
 460' Shale
 525' Sand
 1450' Shale and Shells
 1488' Anhydrite
 1500' Shale
 1525' Shale and Shells
 2300' Shale and Lime
 2350' Lime and Shale
 2485' Lime w/Shale Streaks
 2720' Lime and Shale
 2776' Lime
 3145' Lime and Shale
 3195' Shale
 3330' Lime and Shale
 3455' Shale
 3535' Shale and Lime
 4007' Lime and Shale
 4084' Lime
 4142' Lime and Shale
 4278' Lime
 4325' Lime and Shale
 4571' Lime
 4595' Lime and Chert
 4625' Lime
 4625' RTD

RECEIVED
STATE CORPORATION COMMISSION

JUL 24 1964

CONSERVATION DIVISION
Wichita, Kansas

State of Kansas }
County of Barton } SS

I, Sam N. Stephens of Garvey Drilling Company
upon oath state the above and foregoing is a true and correct copy of the log of the Lippoldt D-1 well.

Subscribed and sworn to before me this 4th day of June 19 64

My Commission Expires: September 23rd, 1967

NOTARY PUBLIC