


15.083.21027.0000

WELL PLUGGING RECORD

Give All Information Completely
 Make Required Affidavit

COUNTY Hodgeman SEC. 22 TWP. 23S RGE. 23W
 Location as in quarters or footage from lines:
C SW NE

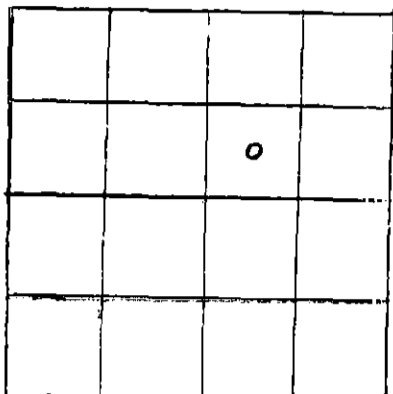

Locate Well
 correctly on above
 Section Platt.

Lease Owner American Energies Corporation
 Lease Name Benish Well No. 1
 Office Address 575 Fourth Financial Center, Wichita, KS 67202
 Character of Well (Completed as Oil, Gas or Dry Hole): Dry Hole
 Date Well Completed December 10, 1982
 Application for plugging filed December 10, 1982
 Plugging commenced December 10, 1982
 Plugging completed December 10, 1982
 Reason for abandonment of well or producing formation _____

Was permission obtained from the Conservation Division or it's
 Agent's before plugging was commenced? yes

Name of Conservation Agent who supervised plugging of this well Dodge City, Kansas

Producing formation _____ Depth to top _____ bottom _____ T.D. 4670

Show depth and thickness of all water, oil and gas formations.

OIL, GAS OR WATER RECORDS

Casing Record

Formation	Content	From	To	Size	Put in	Pulled Out
Surface	Shale	0	508	8-5/8"	508	none

Describe in detail the manner in which the well was plugged, indicating where the mud
 fluid was placed and the method or methods used in introducing it into the hold. If cement
 or other plugs were used, state the character of same and depth placed, from _____ feet
 to _____ feet for each plug set.

Plugged as follows with 50/50 poz 4% gel, 3% cc
 70 sx @ 1470'; 40 sx @ 470'; 10 sx in rathole and 10 sx @ 40'
 with solid bridge plug.
 Jobe completed at 3 p.m. 12-10-82 by Sun Cementing.

(If additional description is necessary, use BACK of this sheet)

Name of Plugging Contractor J. W. Drilling Co., Inc.

STATE OF KANSAS COUNTY OF SEDGWICK, ss.

Jon T. Williams, Jr. (employee of owner) or (owner or operator) of the
 above-described well, being first duly sworn on oath, says: That I have knowledge of the
 facts, statements, and matters herein contained and the log of the above-described well as
 filed and that the same are true and correct. So help me God.

(Signature) [Signature]
 200 E. First, Suite 500, Wichita, KS
 (Address)

this 10th day of December, 19 82

Geraldine Stewart
 Notary Public.

My Commission Expires: January 14, 1985

