


15.083.00149.00.00

WELL PLUGGING RECORD

Give All Information Completely
Make Required Affidavit
Mail or Deliver Report to:
Conservation Division
State Corporation Commission
212 North Market, Insurance Bldg.
Wichita, Kansas

HODGEMAN County, Sec. 21 Twp. 23S Rge. 23W (#) (W)
Location as "NE/CNW/SW" or footage from lines C. SW NW
Lease Owner PETROLEUM, INC.
Lease Name JARNAGIN Well No. 1
Office Address ROUTE 2, GREAT BEND, KANSAS
Character of Well (completed as Oil, Gas or Dry Hole) DRY HOLE
Date well completed FEBRUARY 18 19 60
Application for plugging filed FEBRUARY 18 19 60
Application for plugging approved FEBRUARY 18 19 60
Plugging commenced FEBRUARY 18 19 60
Plugging completed FEBRUARY 18 19 60
Reason for abandonment of well or producing formation NO PRODUCIBLE ZONES

NORTH

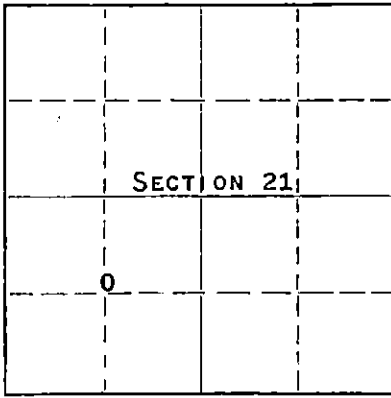

Locate well correctly on above
Section Plat

If a producing well is abandoned, date of last production NONE 19
Was permission obtained from the Conservation Division or its agents before plugging was commenced? YES

Name of Conservation Agent who supervised plugging of this well MR. FRANK BROADFOOT
Producing formation --- Depth to top --- Bottom --- Total Depth of Well 4720 Feet
Show depth and thickness of all water, oil and gas formations.

OIL, GAS OR WATER RECORDS

CASING RECORD

FORMATION	CONTENT	FROM	TO	SIZE	PUT IN	PULLED OUT
				8-5/8"	475'	NONE

Describe in detail the manner in which the well was plugged, indicating where the mud fluid was placed and the method or methods used in introducing it into the hole. If cement or other plugs were used, state the character of same and depth placed, from feet to feet for each plug set.

MUD UP WITH HEAVY MUD TO 400' FOLLOWED BY A WOODEN PLUG AND 1/4 SACK HULLS, PLACED 20 SACKS OF CEMENT THROUGH DRILL PIPE ON TOP OF PLUG. MUD UP TO 35' FOLLOWED BY A WOODEN PLUG AND 1/4 SACK OF HULLS. FILLED HOLE TO BASE OF WELL CELLAR WITH 10 SACKS OF CEMENT.

RECEIVED
STATE CORPORATION COMMISSION
MAR 28 1960
CONSERVATION DIVISION
Wichita, Kansas

3-28-1960

(If additional description is necessary, use BACK of this sheet)

Name of Plugging Contractor GARVEY DRILLING COMPANY
Address ROUTE 2, GREAT BEND, KANSAS

STATE OF KANSAS, COUNTY OF BARTON, ss.
DON SEARLE (employee of owner) or (~~owner~~) of the above-described well, being first duly sworn on oath, says: That I have knowledge of the facts, statements, and matters herein contained and the log of the above-described well as filed and that the same are true and correct. So help me God.

(Signature) Don Searle

ROUTE 2, GREAT BEND, KANSAS
(Address)

SUBSCRIBED AND SWORN TO before me this 9TH day of MARCH, 19 60

Arthur J. Miles
ARTHUR J. MILES Notary Public.

My commission expires APRIL 14, 1963



15.083.00149.00.00
WELL LOG

COMPANY PETROLEUM, INCORPORATED

SEC. 21 T.23S R. 23W

FARM JARNAGIN NO. 1


LOC. C, SW, NW

TOTAL DEPTH 4720'

COUNTY HODGEMAN CO., KANSAS

COMM. February 2, 1960 COMP. February 18, 1960

CONTRACTOR GARVEY DRILLING COMPANY

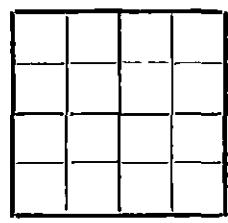

CASING 8 5/8" @ 475' w/250 sax.

ELEVATION

PRODUCTION D & A

FIGURES INDICATE BOTTOM OF FORMATIONS

193	Surface clay & shale
742	Shale
950	Red bed & shale
981	Anhydrite
1030	Shale
1260	Sand
1600	Shale
2400	Shale & lime
2660	Lime
2780	Shale & lime
2858	Lime
3400	Shale & lime
3475	Lime
3615	Shale & lime
3760	Shale & chalky lime
3906	Lime
3997	Shale & lime
4070	Lime & shale
4501	Lime
4584	Lime & shale
4648	Lime
4660	Cherty lime & shale
4673	Cherty lime
4720	Lime
4720	T. D.

RECEIVED
STATE CONSERVATION COMMISSION
MAR 28 1960
CONSERVATION DIVISION
Wichita, Kansas

State of KANSAS }
County of BARTON } ss:

I, VERNE A. MORRIS of GARVEY DRILLING COMPANY

upon oath state that the above and foregoing is a true and correct copy of the log of the #1 JARNAGIN well.

Verne A. Morris

Subscribed and sworn to before me this 7th day of March 19 60

My Commission Expires: April 14, 1963

Arthur J. Miles
NOTARY PUBLIC