


STATE OF KANSAS
STATE CORPORATION COMMISSION

Give All Information Completely
Make Required Affidavit
Mail or Deliver Report to:
Conservation Division
State Corporation Commission
212 North Market, Insurance Bldg.
Wichita, Kansas

15.083.00/48.00.00

WELL PLUGGING RECORD

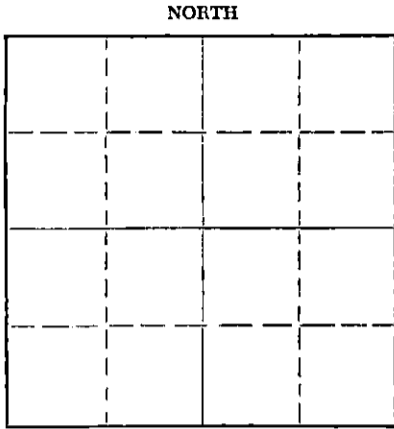

Locate well correctly on above Section Plat

Hodgeman County. Sec. 15 Twp. 23S Rge. 23 (E) W (W)
Location as "NE/CNW/SW" or footage from lines C NE NE
Lease Owner Edward F. Lippoldt
Lease Name Lippoldt #1 Fee Well No. 1
Office Address Kinsley, Kansas
Character of Well (completed as Oil, Gas or Dry Hole) Dry Hole
Date well completed August 27 19 59
Application for plugging filed 19
Application for plugging approved 19
Plugging commenced August 27 19 59
Plugging completed August 27 19 59
Reason for abandonment of well or producing formation Dry

If a producing well is abandoned, date of last production 19
Was permission obtained from the Conservation Division or its agents before plugging was commenced? Yes

Name of Conservation Agent who supervised plugging of this well Lou Brock - Great Bend
Producing formation Depth to top Bottom Total Depth of Well 4620 Feet
Show depth and thickness of all water, oil and gas formations.

OIL, GAS OR WATER RECORDS

CASING RECORD

FORMATION	CONTENT	FROM	TO	SIZE	PUT IN	PULLED OUT
				8-5/8"	300'	None

Describe in detail the manner in which the well was plugged, indicating where the mud fluid was placed and the method or methods used in introducing it into the hole. If cement or other plugs were used, state the character of same and depth placed, from feet to feet for each plug set.

Cemented bottom plug @240' with 20 sacks of cement
Cemented top plug @ 35' with 10 sacks of cement

RECEIVED
STATE CORPORATION COMMISSION
AUG 31 1959
CONSERVATION DIVISION
Wichita, Kansas

(If additional description is necessary, use BACK of this sheet)
Name of Plugging Contractor Hilton Drilling Company, Inc.
Address 925 Patton Road, (P. O. Box 108), Great Bend, Kansas

STATE OF Kansas, COUNTY OF Barton, ss.
Henry Peacock - Land Department (employee of owner) or (owner or operator) of the above-described well, being first duly sworn on oath, says: That I have knowledge of the facts, statements, and matters herein contained and the log of the above-described well as filed and that the same are true and correct. So help me God.

(Signature) Henry Peacock
Great Bend, Kansas
(Address)

SUBSCRIBED AND SWORN TO before me this 28th day of August, 19 59
Carmen Reinhardt Leiker
Carmen Reinhardt Leiker Notary Public.

My commission expires January 26, 1963

PLUGGING
FILE SEC. 15 T. 23 R. 23W
BOOK PAGE LINE 1

15.083.00/48.00.00
DRILLER'S LOG

COMPANY: EDWARD F. LIPPOLDT LOCATION: C NE NE
CONTRACTOR: HILTON DRILLING Co., INC. SECTION 15-23S-23W
FARM NAME: LIPPOLDT #1 FEE ELEVATION: 2298 DF
COMMENCED: AUGUST 12, 1959 CASING USED: 8 5/8" @ 300' w/225 sx.
COMPLETED: AUGUST 27, 1959

CLAY	40
CLAY & SHALE	60
SHALE & SAND	300
SHALE	365
SHALE & RED BED	805
GYPSUM	840
RED BED	890
RED BED, SHALE & SHELLS	1470
SHALE & SAND	1880
SHALE & SHELLS	2195
LIME & SHALE	2320
LIME	2460
LIME & SHALE	2555
LIME	2675
LIME & SHALE	2805
LIME	2945
LIME & SHALE	3556
LIME, CHALK & SHALE	3710
LIME & SHALE	3985
LIME	4500
LIME, SHALE & CHERT	4549
CONGLOMERATE	4565
CONGLOMERATE, SHALE & CHERT	4590
LIME & CHERT	4620
TOTAL DEPTH	4620

RECEIVED
STATE CORPORATION COMMISSION
AUG 31 1959
CONSERVATION DIVISION
Wichita, Kansas

STATE OF KANSAS)
COUNTY OF BARTON) SS

I, THE UNDERSIGNED, BEING DULY SWORN ON OATH, STATE THAT THE ABOVE STATEMENT AND LOG ARE TRUE AND A CORRECT RECORD AND LOG OF THE WELL DRILLED AT THE LOCATION ABOVE DESCRIBED.

HILTON DRILLING COMPANY, INC.


HENRY PEACOCK, LAND DEPARTMENT

SUBSCRIBED AND SWORN TO BEFORE ME THIS 28TH DAY OF AUGUST, 1959.


CARMEN REINHARDT LEIKER,
NOTARY PUBLIC

MY COMMISSION EXPIRES JANUARY 26, 1963

PLUGGING
FILE SEC. 15 T. 23 R. 23 W
BOOK PAGE 1 LINE 1