


15.083.00021.00.00
WELL PLUGGING RECORD

Give All Information Completely
Make Required Affidavit
Mail or Deliver Report to:
Conservation Division
State Corporation Commission
212 North Market, Insurance Bldg.
Wichita, Kansas

Hodgeman County, Sec. 25 Twp. 23S Rge. (E) 26 (W)
Location as "NE/CNW%SW%" or footage from lines Con. NW/4 SW/4
Lease Owner Birmingham-Bartlett Drilling Co.
Lease Name GLUNT "A" Well No. 1
Office Address 300 Kaufman Building, Wichita 2, Kansas
Character of Well (completed as Oil, Gas or Dry Hole) Dry Hole
Date well completed May 15, 19 61
Application for plugging filed May 15, 19 61
Application for plugging approved (verbally approved) May 15, 19 61
Plugging commenced May 15, 19 61
Plugging completed May 15, 19 61
Reason for abandonment of well or producing formation Dry Hole

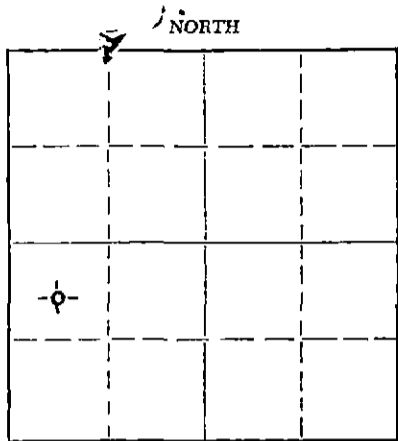

Locate well correctly on above Section Plat

If a producing well is abandoned, date of last production ----- 19____
Was permission obtained from the Conservation Division or its agents before plugging was commenced? Yes

Name of Conservation Agent who supervised plugging of this well Frank Broadfoot
Producing formation _____ Depth to top _____ Bottom _____ Total Depth of Well 4810 Feet
Show depth and thickness of all water, oil and gas formations.

OIL, GAS OR WATER RECORDS

CASING RECORD

FORMATION	CONTENT	FROM	TO	SIZE	PUT IN	PULLED OUT
		0	215	8-5/8"	215'	None

Describe in detail the manner in which the well was plugged, indicating where the mud fluid was placed and the method or methods used in introducing it into the hole. If cement or other plugs were used, state the character of same and depth placed, from _____ feet to _____ feet for each plug set.

Plugged hole. Bottom plug set at 200' with 20 sacks cement mixed and poured thru drill pipe. Hole filled with mud up to 35'. Plug set at 35' with 10 sacks cement.

RECEIVED
STATE CORPORATION COMMISSION
MAY 17 1961
CONSERVATION DIVISION
Wichita, Kansas

(If additional description is necessary, use BACK of this sheet)
Name of Plugging Contractor Birmingham-Bartlett Drilling Co.
Address 300 Kaufman Building, Wichita 2, Kansas

STATE OF KANSAS, COUNTY OF SEDGWICK
Richard Hindery, partner of Birmingham-Bartlett Drilling Co. Operator
(employee of the owner, partner, owner, or operator) of the above-described well, being first duly sworn on oath, says: That I have knowledge of the facts, statements, and matters herein contained and the log of the above-described well as filed and that the same are true and correct. So help me God.

(Signature) Richard Hindery
Richard Hindery, Partner
300 Kaufman Building, Wichita 2, Kansas
(Address)

SUBSCRIBED AND SWORN TO before me this 16th day of May 19 61

Vivian F. Yinger
Vivian F. Yinger Notary Public.

My commission expires November 29, 1962.



15.083.00621.00.00

GLUNT "A" NO. 1 WELL

LOCATION: C - NW/4 SW/4 SPUDDED: 5- 1-61
 Section 25-23S-23W
 Hodgeman County, Kansas COMPLETED: 5-15-61

MINING, OPERATOR
 and CONTRACTOR: Birmingham-Bartlett Drilling Co.
 300 Kaufman Building
 Wichita 2, Kansas

SURFACE CASING: 8-5/8" cemented at 215' with
 160 sacks cement.

OIL STRING: None set. D & A. Plugged on 5-15-61.

L O G

(Figures indicate bottom of formation)

0 -	20	Surface clay
	70	Shale and shells
	100	Sand
	460	Shale and shells
	560	Sand
	820	Shale and shells
	985	Sand
	1080	Shale and red bed
	1265	Shale and shells
	1445	Sand
	1753	Red bed
	1783	Anhydrite
	2100	Shale and red bed
	2420	Sandy shale and shells
	3755	Shale and lime
	3907	Lime
	4178	Shale and lime
	4253	Lime
	4285	Shale and lime
	4390	Lime
	4455	Shale and lime
	4525	Lime
	4550	Shale and lime
	4650	Lime
	4685	Shale and lime
	4735	Lime
	4759	Chert
	4775	Cherty lime
	4810	Lime
	4810	Rotary Total Depth

RECEIVED
 STATE CORPORATION COMMISSION
 MAY 17 1961
 CONSERVATION DIVISION
 Wichita, Kansas

The undersigned, Richard Hindery, one of the partners of Birmingham-Bartlett Drilling Co., hereby certifies that the above is a true and correct log of the Glunt "A" No. 1 Well as shown in the daily drilling reports.

BIRMINGHAM-BARTLETT DRILLING CO.

By Richard Hindery
Richard Hindery, Partner

Subscribed and sworn to before me this 16th day of May, 1961.

Vivian F. Yinger
Vivian F. Yinger, Notary Public
My commission expires November 29, 1962.