


STATE OF KANSAS  
STATE CORPORATION COMMISSION

15.083.00137.00.00  
WELL PLUGGING RECORD

Give All Information Completely  
Make Required Affidavit  
Mail or Deliver Report to:  
Conservation Division  
State Corporation Commission  
212 North Market, Insurance Bldg.  
Wichita, Kansas

Hodgeman County, Sec. 21 Twp. 23 Rge. 26 (X) (W)  
Location as "NE/CNW/SW" or footage from lines C NW NE  
Lease Owner Prime Drilling Co. & Kaiser-Francis  
Lease Name Boxberger Well No. 1  
Office Address 814 Union Center, Wichita, Kansas  
Character of Well (completed as Oil, Gas or Dry Hole) Dry hole  
Date well completed May 2 1962  
Application for plugging filed May 2 1962  
Application for plugging approved May 2 1962  
Plugging commenced May 2 1962  
Plugging completed May 2 1962  
Reason for abandonment of well or producing formation no oil and/or gas found  
in commercial quantities  
If a producing well is abandoned, date of last production 19  
Was permission obtained from the Conservation Division or its agents before plugging was commenced? Yes

NORTH

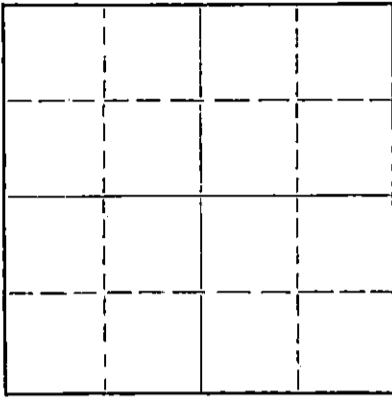

Locate well correctly on above  
Section Flat

Name of Conservation Agent who supervised plugging of this well W. L. LaKamp  
Producing formation \_\_\_\_\_ Depth to top \_\_\_\_\_ Bottom \_\_\_\_\_ Total Depth of Well \_\_\_\_\_ Feet  
Show depth and thickness of all water, oil and gas formations.

OIL, GAS OR WATER RECORDS

CASING RECORD

FORMATION	CONTENT	FROM	TO	SIZE	PUT IN	PULLED OUT
				8-5/8"	325'	none

Describe in detail the manner in which the well was plugged, indicating where the mud fluid was placed and the method or methods used in introducing it into the hole. If cement or other plugs were used, state the character of same and depth placed, from \_\_\_\_\_ feet to \_\_\_\_\_ feet for each plug set.

Filled hole with extra heavy rotary mud from total depth to 300'. Set Plug #1 and 25 sacks cement. Filled hole with extra heavy rotary mud from Plug #1 to 35'. Set Plug #2 at 35' and 10 sacks cement.

RECEIVED  
STATE CORPORATION COMMISSION

MAY 8 1962

CONSERVATION DIVISION  
Wichita, Kansas

(If additional description is necessary, use BACK of this sheet)

Name of Plugging Contractor Prime Drilling Company  
Address 814 Union Center, Wichita, Kansas

STATE OF Kansas, COUNTY OF Sedgwick, ss.  
R. R. McNicol (employee of owner) or (owner or operator) of the above-described well, being first duly sworn on oath, says: That I have knowledge of the facts, statements, and matters herein contained and the log of the above-described well as filed and that the same are true and correct. So help me God.

(Signature) R.R. McNicol  
814 Union Center, Wichita, Kansas  
(Address)

SUBSCRIBED AND SWORN TO before me this 7th day of May, 1962

My commission expires March 12, 1966

Jerrie S. Ward  
Notary Public.



15.083.00/37.00.00

ROTARY DRILLING LOG

OPERATOR: Prime, Kaiser-Francis  
BOXBERGER, #1  
C NW NE Sec. 21-23S-26W,  
Hodgeman County, Kansas.

CONTRACTOR: Prime Drilling Company  
COMM: 4-18-62  
COMP: 5-3-62

Remarks: Set 8-5/8" surface casing at 325'  
w/ 250 sx. Pozmix HA5.

Formations:

Soil & Sandy lime	75'
Lime Shells & Shale	265'
Shale & Shells	530'
Sand	630'
Shale & Shells	890'
Shale, Shell & Sand	1150'
Shale, Sand & Red Bed	1249'
Shale, Sand & Shells	1465'
Shale & Lime	1735'
Shale & Red Bed	1820'
Anhydrite	1850'
Shale & Lime	2225'
Lime & Shale	2285'
Lime & Shale	2720'
Lime	2841'
Lime & Shale	2900'
Lime	3052'
Shale & Lime	3075'
Chalk, Lime & Shale	3135'
Shale & Lime	3180'
Lime & Chalk	3285'
Lime & Shale	3365'
Chalk & Lime streaks	3460'
Shale & Lime	3507'
Lime & Shale Streaks	3570'
Lime & Shale	3676'
Shale & Lime streaks	3810'
Lime & Shale	3832'
Lime	3888'
Shale & Lime	4017'
Sand	4037'
Lime	4645'
Lime & Shale	4682'
Lime	4758'
Mississippi	4794'
Lime	4818'
Rotary Total Depth (D & A)	4818'

We certify the above log is true and correct to the best of our knowledge and belief.

PRIME DRILLING COMPANY

By *R-R. McNicol*  
R. R. McNicol