

STATE OF KANSAS  
STATE CORPORATION COMMISSION

Give All Information Completely  
Make Required Affidavit  
Mail or Deliver Report to:  
Conservation Division  
State Corporation Commission  
211 No. Broadway  
Wichita, Kansas


WELL PLUGGING RECORD

15.083.00-139.00.00

Hodgeman County, Sec. 12 Twp. 23S Rge. (X) 26 (W)

Location as "NE/CNWSW" or footage from lines C SE SW  
Lease Owner Helmerich & Payne Inc.  
Lease Name BUNDY Well No. 1  
Office Address First National Bank Bldg., Tulsa, Okla.  
Character of Well (completed as Oil, Gas or Dry Hole) Dry Hole  
Date well completed 7 January 1962  
Application for plugging filed 7 January 1962  
Application for plugging approved 7 January 1962  
Plugging commenced 7 January 1962  
Plugging completed 7 January 1962  
Reason for abandonment of well or producing formation Dry Hole

NORTH

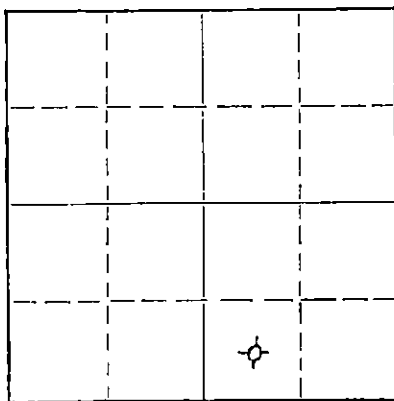

Locate well correctly on above Section Plat

If a producing well is abandoned, date of last production \_\_\_\_\_ 19\_\_\_\_  
Was permission obtained from the Conservation Division or its agents before plugging was commenced? Yes

Name of Conservation Agent who supervised plugging of this well W. L. Lackamp Jr. Stafford  
Producing formation \_\_\_\_\_ Depth to top \_\_\_\_\_ Bottom \_\_\_\_\_ Total Depth of Well 4832 Feet  
Show depth and thickness of all water, oil and gas formations.

OIL, GAS OR WATER RECORDS

CASING RECORD

FORMATION	CONTENT	FROM	TO	SIZE	PUT IN	PULLED OUT
		0	302	8-5/8"	302	None

Describe in detail the manner in which the well was plugged, indicating where the mud fluid was placed and the method or methods used in introducing it into the hole. If cement or other plugs were used, state the character of same and depth placed, from \_\_\_\_\_ feet to \_\_\_\_\_ feet for each plug set.

From: 4832 to 290 Heavy Rotary Mud  
290 to 230 1/4 sack Hulls, Plug & 20 sacks cement.  
230 to 35 Heavy Rotary Mud  
35 to 4 1/4 sack Hulls, Plug & 10 sacks cement.  
4 to 0 Cellar

Plugging Completed 1:00 PM 7 January 1962

STATE CORPORATION COMMISSION

FEB 7 1962

CONSERVATION DIVISION  
Wichita, Kansas

2-5-62

(If additional description is necessary, use BACK of this sheet)

Name of Plugging Contractor Sierra Petroleum Co. Inc.  
Address 208 Petro. Bldg., Wichita 2, Kansas

STATE OF Kansas, COUNTY OF Finney, ss.  
T. E. Mort (employee of owner) or ~~(owner)~~ of the above-described well, being first duly sworn on oath, says: That I have knowledge of the facts, statements, and matters herein contained and the log of the above-described well as filed and that the same are true and correct. So help me God.

(Signature) T. E. Mort  
Box 255 Garden City, Kansas  
(Address)

SUBSCRIBED AND SWORN TO before me this 7 day of January, 1962

My commission expires 1 July 1964  
Robert N. Boyd Notary Public.

15.083.00139.00.00

WELL PLUGGING RECORD

TO: State Corporation Commission  
Conservation Division  
500 Insurance Building  
212 No. Market  
Wichita 2, Kansas

RECEIVED  
STATE CORPORATION COMMISSION

JAN 11 1962

FROM: Helmerich & Payne, Inc.  
Home Office - First National Bank Building  
Tulsa 3, Oklahoma

CONSERVATION DIVISION  
Wichita, Kansas

EVERETT BUNDY #1  
C SE SW  
Sec. 12-23S-26W  
Hodgeman County, Kansas

Date Well Completed: 1-7-62  
Appl. Plug. Filed : 1-7-62  
Appl. Plug. Apprvd.: 1-7-62  
Plugging Commenced : 1-7-62  
Plugging Completed: 1-7-62  
Reason for abandonment of well or producing formation: DRY HOLE

Was permission obtained from the Conservation Division or its agents before plugging was commenced? YES

Name of Conservation Agent: MR. FRANK BROADFOOT, ST. JOHN, KANSAS

T. D.: 4832'

OIL, GAS OR WATER RECORDS

FORMATION : SURFACE SOIL & CLAY, SHALE & SHELLS  
CONTENT : SURFACE CASING  
FROM : -0-  
TO : 302' KB  
SIZE : 8-5/8"  
PUT IN : 302' KB  
PULLED OUT: NONE

DESCRIBE IN DETAIL THE MANNER IN WHICH THE WELL WAS PLUGGED.

PLUGGED: FILLED HOLE WITH MUD FROM 4832' to 290',  
1/4 SK. HULLS & PLUG @ 290' WITH 20 SX.  
CEMENT THROUGH DRILL PIPE. FILLED WITH  
MUD UP TO 35', HULLS, BRIDGE & PLUG @  
35', 10 SX. CEMENT. FILLED TO BASE OF  
CELLAR.

COMPLETED @ 1 P.M., 1-7-62.

NAME OF PLUGGING CONTRACTOR: SIERRA PETROLEUM CO., INC.  
ADDRESS: 208 PETROLEUM BUILDING, WICHITA, KANSAS

STATE OF KANSAS )  
                          ) ss:  
COUNTY OF RUSSELL )

C. T. HONAKER (employee of owner) or (owner  
or operator) of the above-described well, being first duly sworn on oath,  
says: That I have knowledge of the facts, statements, and matters herein  
contained and the log of the above-described well as filed and that the same  
are true and correct. So help me God.

*C. T. Honaker*  
(Signature) C. T. HONAKER, DRIG. SUPT.  
(Address) BOX 232, RUSSELL, KANSAS

Subscribed and sworn to before me this 8th day of January, 1962.

*Leroy Dyer*  
\_\_\_\_\_  
Notary Public.

My commission expires: 10-17-63

15.083.00-139.00.00

HELMERICH & PAYNE, INC. - Operator

SIERRA PETROLEUM CO., INC. - Contr.

EVERETT BUNDY #1  
C SE SW  
Sec. 12-23S-26W  
Hodgman County, Kansas

T. D.: 4832'

Commenced: 12-19-61

Completed: 1-7-62

Casing:

8-5/8" Set at 302' KB

Cement:

with 250 sx. cement

FORMATION

DEPTH

Surface Clay & Shale	40
Shale & Shells	303
Shale & Shells	840
Sand	920
Shale & Shells	1115
Red Bed	1142
Anhydrite	1160
Shale & Shells	1500
Shale & Shells	1790
Shale & Lime	2450
Lime	3860
Lime & Shale	3970
Lime	4752
Lime Chert	4779
Mississippi	4795
Lime Chert	4832

RECEIVED  
STATE CORPORATION COMMISSION

JAN 9 1962

CONSERVATION DIVISION  
Topeka, Kansas

STATE OF KANSAS )  
                          ) ss:  
COUNTY OF RUSSELL )

I hereby certify that the above information is true  
and correct to the best of my knowledge.

C.T. Honaker

Subscribed and sworn to before me this 8th day of January,  
1962.

Leroy Bundy  
Notary Public

My commission expires: 10-17-63