

WELL PLUGGING RECORD

Give All Information Completely
Make Required Affidavit
File or Deliver Report to
Conservation Division
State Corporation Comm.
245 North Water
Wichita, KS 67202

Hodgeman County, Sec. 15 Twp. 22S Rge. 26W E/A
Location as "NE/CNW $\frac{1}{2}$ SW $\frac{1}{2}$ " or footage from lines
SW SE


Lease Owner PICKRELL DRILLING COMPANY
Lease Name GLUNT "C" Well No. 1
Office Address 205 LITWIN BLDG., WICHITA, KS. 67202
Character of Well (Completed as Oil, Gas or Dry Hole)
DRY HOLE

Date Well completed 8-27-78 19
Application for plugging filed 8-27-78 19
Application for plugging approved 8-27-78 19
Plugging commenced 8-27-78 19
Plugging completed 8-27-78 19
Reason for abandonment of well or producing formation
DRY HOLE

If a producing well is abandoned, date of last production 19

Was permission obtained from the Conservation Division or its agents before plugging was commenced? YES

Name of Conservation Agent who supervised plugging of this well William T. Owen
Producing formation Depth to top Bottom Total Depth of Well 4565
Show depth and thickness of all water, oil and gas formations.

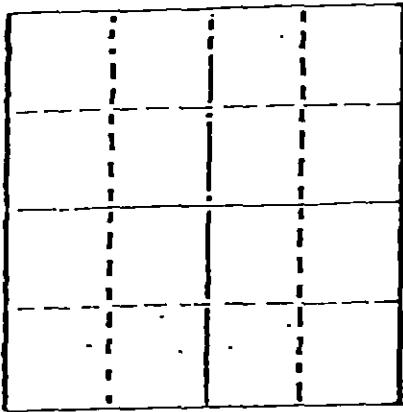

Look well correctly on above Section Plot

OIL, GAS OR WATER RECORDS

CASING RECORD

FORMATION	CONTENT	FROM	TO	SIZE	PUT IN	PULLED OUT
				8 5/8	239	None

Describe in detail the manner in which the well was plugged, indicating where the mud flux was placed and the method or methods used in introducing it into the hold. If cement or other plugs were used, state the character of same and depth placed, from feet to feet for each plug set.

50 sacks at 3500'
35 sacks at 240'
12 sacks at 40'
3 sacks in Rat Hole

RECEIVED
STATE CORPORATION COMMISSION
Comp. 3122078

SEP 11 1978

CONSERVATION DIVISION
Wichita, Kansas

9-11-78

(If additional description is necessary, use BACK of this sheet)

Name of Plugging Contractor Pickrell Drilling Company

STATE OF Kansas COUNTY OF Sedgwick, ss.

C. W. Sebitts

(employee of owner) or (owner or operator)

of the above-described well, being first duly sworn on oath, says: That I have knowledge of the facts, statements, and matters herein contained and the log of the above-described well filed and that the same are true and correct. So help me God. BY: C. W. Sebitts

(Signature)

205 Litwin Bldg., Wichita, Ks. 67208

(Address)

SUBSCRIBED AND SWORN TO before me this 6 day of September, 1978

Jo Ann Sarver
Notary Public.

commission expires



ROTARY DRILLING LOG

COMPANY: PICKRELL DRILLING COMPANY
205 LITWIN BLDG.
WICHITA, KS. 67208
LOCATION: GLUNT "C" #1
SW SE Sec. 15-22S-26W
Hodgeman Co., Ks.
CONTRACTOR: **PICKRELL DRILLING COMPANY**
Wichita, Kansas

Rotary Drilling Commenced 8-19-78
Rotary Drilling Completed 8-27-78

CASING RECORD: Spud date 8-19-78 Surf. pipe 8 5/8" set at 239' with 150sx.

LOG

(Figures indicate bottom of formation — measurements from top of rotary bushing.)

Sand	.71
Shale	242
Shale	.750
Shale & Red Beds	1128
Sand	1316
Shale	1600
Shale & Red Beds	1623
Shale	1633
Shale	1848
Shale	2280
Shale & Lime	2415
Lime & Shale	2611
Lime	2760
Lime & Shale	2905
Lime & Shale	3093
Lime & Shale	3245
Lime & Shale	3375
Lime & Shale	3529
Lime & Shale	3680
Lime & Shale	3830
Lime & Shale	3966
Lime	4080
Lime	4185
Lime	4292
Lime	4375
Lime & Shale	4440
Lime & Shale	4512
Lime	4565

RECEIVED
STATE CORPORATION COMMISSION

SEP 11 1978

CONSERVATION DIVISION
Wichita, Kansas

The undersigned, C. W. Sebitts, Attorney-in-Fact for PICKRELL DRILLING COMPANY, hereby certifies in behalf of said Company, that the above is a true and correct log of the formation encountered in drilling the above well as reflected by the Daily Drilling Reports.

PICKRELL DRILLING COMPANY

By [Signature]
Attorney-in-Fact
C. W. Sebitts

STATE OF KANSAS }
COUNTY OF SEDGWICK } ss.:

On this 6 day of September, 1978, before me the undersigned, a Notary Public, in and for the County and State aforesaid, personally appeared C. W. Sebitts, to me known to be the identical person who subscribed the name of PICKRELL DRILLING COMPANY to the foregoing instrument as its Attorney-in-Fact and acknowledged to me that he executed the same as his free and voluntary act and deed, and as the free and voluntary act and deed of such company, for the uses and purposes therein set forth.

Given under my hand and seal of office the day and year last above written.

My commission expires: _____

[Signature]
Notary Public

Jo Ann Sarver

