


Give All Information Completely
Make Required Affidavit
or Deliver Report to:
Conservation Division
State Corporation Commission
212 No. Market
Wichita, Kansas

WELL PLUGGING RECORD

Seward County, Sec. 25 Twp. 34S Rge. (E) 31 (W)

Location as "NE/CNW/SW" or footage from lines C SW NE
Lease Owner Anadarko Production Company
Lease Name Adams "C" Well No. 2
Office Address Box 351 Liberal, Kansas 67901
Character of Well (completed as Oil, Gas or Dry Hole) Oil
Date well completed 12/6 1970
Application for plugging filed 2/3 1972
Application for plugging approved 2/8 1972
Plugging commenced 3/21 1972
Plugging completed 3/22 1972
Reason for abandonment of well or producing formation Non-economical

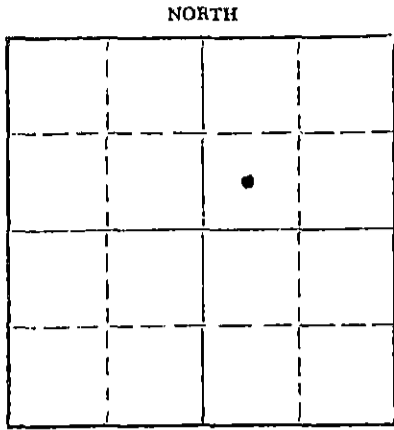

Locate well correctly on above Section Plat

If a producing well is abandoned, date of last production 12/1 19 71
Was permission obtained from the Conservation Division or its agents before plugging was commenced? Yes

Name of Conservation Agent who supervised plugging of this well Mr. Ed Eves Box F Sublette, Kansas 67877
Producing formation _____ Depth to top _____ Bottom _____ Total Depth of Well 4390 Feet
Show depth and thickness of all water, oil and gas formations.

OIL, GAS OR WATER RECORDS

CASING RECORD

FORMATION	CONTENT	FROM	TO	SIZE	PUT IN	PULLED OUT
Lansing	Gas	4260	4270	8 5/8	1274'	NONE
Toronto	Oil	4154	4156	4 1/2	4389'	3225'
		4149	4151			

Describe in detail the manner in which the well was plugged, indicating where the mud fluid was placed and the method or methods used in introducing it into the hole. If cement or other plugs were used, state the character of same and depth placed, from _____ feet to _____ feet for each plug set.

Pumped 25 sxs. cement. Plug to 3850'.

Spotted 35 sxs. cement, from 900' to 800'.

Spotted 15 sxs. cement, from 45' to surface.

Hole filled with mud between plugs.

RECEIVED
STATE CORPORATION COMMISSION
MAR 29 1972
CONSERVATION DIVISION
Wichita, Kansas

(If additional description is necessary, use BACK of this sheet)

Name of Plugging Contractor Sargent's Casing Pulling Service
Address Box 506 Liberal, Kansas 67901

STATE OF KANSAS, COUNTY OF SEWARD, ss.
W. A. BEATTY (employee of owner) or (owner or operator) of the above-described well, being first duly sworn on oath, says: That I have knowledge of the facts, statements, and matters herein contained and the log of the above-described well as filed and that the same are true and correct. So help me God.

(Signature) W.A. BEATTY W.A. Beatty
ASSISTANT TO SUPERINTENDENT
BOX 351 LIBERAL, KANSAS 67901
(Address)

SUBSCRIBED AND SWORN to before me this 28th day of March 1972

My Commission Expires September 9, 1972

Notary Public.



15-175-20118-0000

DRILLER'S LOG

WELL NAME Adams "C" #2 COMPANY OPERATING Anadarko Production Company
 ADDRESS OF COMPANY Box 351 Liberal, Kansas 67901

WELL LOCATION C 1/4 SW 1/4 NE 1/4
3300 Ft. North of South Line,
3304 Ft. East of West Line, Sec. 25, Twp. 34S, Rge. 31W, Seward County, Kansas

DRILLING STARTED 8-25, 1970, DRILLING COMPLETED 9-5, 1970
 WELL COMPLETED 12-6, 1970, WELL CONNECTED _____, 19____

ELEVATION 2440.1 Ft. Ground Level CHARACTER of WELL (Oil, Gas, Dry Hole) OIL

OIL OR GAS SANDS OR ZONES - PERFORATIONS - ACIDIZING AND FRACTURING INFORMATION					
Name	From	To	No. of Shots	Gallons Used	Kind Used
Lansing	4262	4270	16	Acidized 1500	15% NE
				Set CIBP @ 4200'	
Toronto	4149	4151	8	Acidized 750	15% NE
	4154	4156			

CASING RECORD

Size	Amount Set	Sacks of Cement	Amount Pulled
8 5/8"	1274'	730	NONE
4 1/2"	4389'	150	NONE
2 3/8"	4162'	SN @ 4131'	NONE

FORMATION RECORD

Formation	Top	Bottom	Formation	Top	Bottom
Surface Sand & Clay	0	280			
Red Bed	280	400			
Shale & Sand	400	1025			
Red Bed & Anhydrite	1025	1275			
Anhydrite	1275	1295			
Shale & Shells	1295	1655			
Lime	1655	2440			
Lime & Shale	2440	2640			
Lime	2640	3700			
Shale	3700	3950			
Shale & Lime	3950	4138			
Lime	4138	4390			
TOTAL DEPTH	4390				

RECEIVED
 STATE CORPORATION COMMISSION
 JUL 24 1972
 CONSERVATION DIVISION
 Wichita, Kansas

RESULTS OF INITIAL PRODUCTION TEST: State Test: Pumped 31.44 B. O. + 113 BW in 24 hours.