


STATE OF KANSAS
STATE CORPORATION COMMISSION

Give All Information Completely
Make Required Affidavit
Mail or Deliver Report to:
Conservation Division
State Corporation Commission
P. O. Box 17027
Wichita, Kansas 67217
NORTH

WELL PLUGGING RECORD

Seward County. Sec. 25 Twp. 34S Rge. 31 (E) (W) X
Location as "NE/CNW/SW" or footage from lines SE NW
Lease Owner William G. Hughes
Lease Name Adams 25-B Well No. 1
Office Address 5610 S. 77th. E. Ave. Tulsa, Oklahoma 74145
Character of Well (completed as Oil, Gas or Dry Hole) Oil
Date well completed 7-28 19 71
Application for plugging filed 1-30 19 74
Application for plugging approved 2-3 19 74
Plugging commenced 2-6 19 74
Plugging completed 2-7 19 74
Reason for abandonment of well or producing formation water

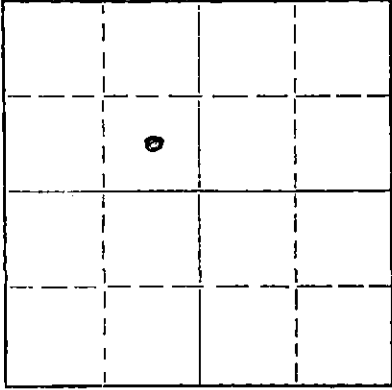

Locate well correctly on above Section Plat

If a producing well is abandoned, date of last production Approx. 10-30 19 73
Was permission obtained from the Conservation Division or its agents before plugging was commenced? Yes

Name of Conservation Agent who supervised plugging of this well Ed Eves
Producing formation 4287 Depth to top Bottom Total Depth of Well 4400 Feet
Show depth and thickness of all water, oil and gas formations.


OIL, GAS OR WATER RECORDS

CASING RECORD

| FORMATION | CONTENT | FROM | TO | SIZE | PUT IN | PULLED OUT |
|-----------|---------|------|----|-------|--------|------------|
| | | | | 8 5/8 | 1281 | none |
| | | | | 4 1/2 | 4398 | 3553 |
| | | | | | | |
| | | | | | | |
| | | | | | | |
| | | | | | | |
| | | | | | | |

Describe in detail the manner in which the well was plugged, indicating where the mud fluid was placed and the method or methods used in introducing it into the hole. If cement or other plugs were used, state the character of same and depth placed, from feet to feet for each plug set.

Pump 20 sks. of cement @ 4187 to 4287
Pump 35 sks. of cement @ 800 to 700
Put 15 sks. of cement @ 45 to 0

 

RECEIVED
STATE CORPORATION COMMISSION
FEB 19 1974
CONSERVATION DIVISION
Wichita, Kansas

(If additional description is necessary, use BACK of this sheet)
Name of Plugging Contractor Sargents Casing Pulling Service Kansas No. 511
Address Box 506 Liberal, Kansas 67901

STATE OF Kansas, COUNTY OF Seward, ss.
Robert Sargent (employee of owner) or (owner or operator) of the above-described well, being first duly sworn on oath, says: That I have knowledge of the facts, statements, and matters herein contained and the log of the above-described well as filed and that the same are true and correct. So help me God.

(Signature) Bill Hughes by Robert Sargent
5610 S 77th E Ave Tulsa Okla Box 506 Liberal Kan.
(Address)

SUBSCRIBED AND SWORN TO before me this 15th day of Feb., 19 74

My commission expires Dec. 11, 1977

Harothy Sargent
Notary Public.

