


STATE OF KANSAS
STATE CORPORATION COMMISSION

Give All Information Completely
Make Required Affidavit
Mail or Deliver Report to:
Conservation Division
State Corporation Commission
211 No. Broadway
Wichita, Kansas

WELL PLUGGING RECORD

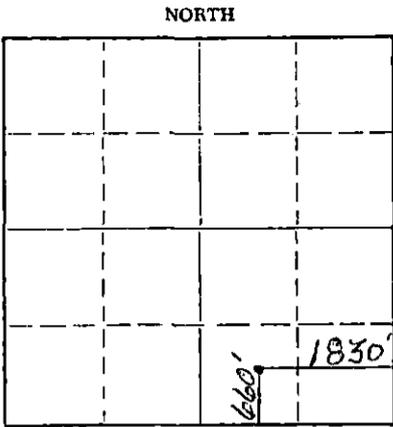

Seward County. Sec. 25 Twp. 34S Rge. 31 (W)
Location as "NE/CNW/SW" or footage from lines 160' East of C-SW-SE
Lease Owner Petroleum, Inc.
Lease Name Adams "O" Well No. 1
Office Address P.O. Box 1255, Liberal, Kansas
Character of Well (completed as Oil, Gas or Dry Hole) Dry Hole
Date well completed July 23, 19 67
Application for plugging filed August 15 19 67
Application for plugging approved August 16 19 67
Plugging commenced August 18 19 67
Plugging completed August 21 19 67
Reason for abandonment of well or producing formation Dry Hole

If a producing well is abandoned, date of last production ----- 19 --
Was permission obtained from the Conservation Division or its agents before plugging was commenced? Yes

Name of Conservation Agent who supervised plugging of this well Edgar Eves
Producing formation NONE Depth to top ----- Bottom ----- Total Depth of Well 6165 Feet
Show depth and thickness of all water, oil and gas formations.

OIL, GAS OR WATER RECORDS

CASING RECORD

FORMATION	CONTENT	FROM	TO	SIZE	PUT IN	PULLED OUT
				20"	61'	NONE
				8 5/8"	1305'	NONE
				4 1/2"	6163'	6163'

Describe in detail the manner in which the well was plugged, indicating where the mud fluid was placed and the method or methods used in introducing it into the hole. If cement or other plugs were used, state the character of same and depth placed, from ----- feet to ----- feet for each plug set.

Mix 15 sacks cement and 1 sack hulls to plug off perforations. Stop plug at 5,800'. Shot pipe at 5,255'. Worked pipe loose. Lay down 52 joints. Fill hole with fresh gell to 700'. Pump 40 sacks cement at 700' to 600'. Fill hole with mud to 45'. Put 15 sacks cement at 45' to 0'.

RECEIVED
STATE CORPORATION COMMISSION

AUG 31 1967

CONSERVATION DIVISION
Wichita, Kansas

(If additional description is necessary, use BACK of this sheet)
Name of Plugging Contractor Sargent's Casing Pulling Service
Address Liberal, Kansas


STATE OF Kansas, COUNTY OF Seward, ss.
Donald Nowak (employee of owner) or (owner or operator) of the above-described well, being first duly sworn on oath, says: That I have knowledge of the facts, statements, and matters herein contained and the log of the above-described well as filed and that the same are true and correct. So help me God.

(Signature) Donald Nowak, Lease Foreman

Box 1255, Liberal, Kansas
(Address)

SUBSCRIBED AND SWORN to before me this 29th August 19 67

My commission expires Sept. 19, 1970

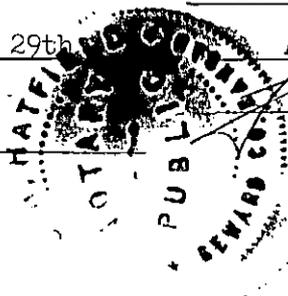

James R. Hitzfield
Notary Public.

WELL LOG

COMPANY Petroleum, Inc.

SEC. 25 T. 34S R. 31W

FARM Adams "0"

NO. 1

LOC. 160' East of C SW SE


TOTAL DEPTH 6165'

COUNTY Seward

COMM. 7-2-67

COMP. 7-23-67

CONTRACTOR Garvey Drilling Company

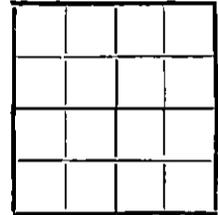

CASING 20" @ 61' w/300 sx
8 5/8" @ 1305' w/650 sx
4 1/2" @ 6163' w/150 sx

ELEVATION

PRODUCTION

FIGURES INDICATE BOTTOM OF FORMATIONS

- 72' Lime Stone
- 702' Sand, Clay, Gyp and Red Bed
- 1305' Red Bed, Sand, and Anhydrite
- 1857' Red Bed, Shale, Anhydrite, Sand and Shale
- 2690' Lime and Shale
- 2800' Lime
- 2971' Lime and Shale
- 3100' Lime, Shale, and Dolomite
- 3340' Lime and Shale
- 3520' Shale and Lime
- 3920' Lime and Shale
- 4107' Shale and Lime
- 4250' Lime and Shale
- 4305' Lime
- 4541' Lime and Shale
- 4860' Lime
- 5111' Lime and Shale
- 5177' Lime
- 5206' Lime and Sand
- 5275' Lime and Sand Shale
- 5560' Lime
- 5635' Lime and Sand
- 5650' Lime and Shale
- 5701' Lime
- 5764' Lime and Shale
- 6165' Lime
- 6165' RTD

RECEIVED
STATE COMMISSION
AUG 16 1967
CONSERVATION DIVISION
Wichita, Kansas

State of Kansas }
County of Barton } ss

I, Sam N. Stephens of Garvey Drilling Company

upon oath state the above and foregoing is a true and correct copy of the log of the Adams "0" No. 1 well.

Sam N. Stephens

Subscribed and sworn to before me this 29th day of July 19 67

My Commission Expires: November 5th, 1969

Richard Stoy
NOTARY PUBLIC