

STATE OF KANSAS  
STATE CORPORATION COMMISSION

Form CP-4


Give All Information Completely  
Make Required Affidavit  
Mail or Deliver Report to:  
Conservation Division  
State Corporation Commission  
212 No. Market  
Wichita, Kansas 67202

WELL PLUGGING RECORD

Pawnee County, Sec. 12 Twp. 22S Rge. (E) 17(W)

Location as "NE/CNW/SW" or footage from lines C NW SW  
Lease Owner Leben Oil Corporation  
Lease Name Smith Well No. #1  
Office Address 200 W. Douglas, Wichita, Kansas 67202  
Character of Well (completed as Oil, Gas or Dry Hole) Dry Hole  
Date well completed December 7, 19 71  
Application for plugging filed December 7, 19 71  
Application for plugging approved December 7, 19 71  
Plugging commenced December 7, 19 71  
Plugging completed December 7, 19 71  
Reason for abandonment of well or producing formation Dry Hole

NORTH

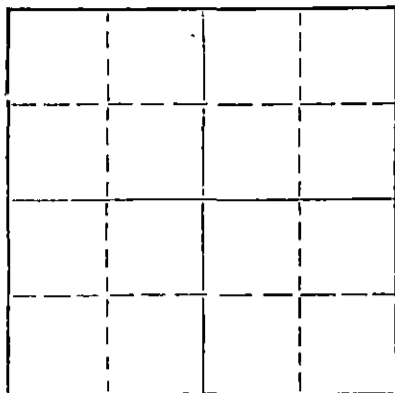

Locate well correctly on above  
Section Plat

If a producing well is abandoned, date of last production \_\_\_\_\_ 19\_\_\_\_  
Was permission obtained from the Conservation Division or its agents before plugging was com-  
menced? Yes

Name of Conservation Agent who supervised plugging of this well Leo Massey  
Producing formation \_\_\_\_\_ Depth to top \_\_\_\_\_ Bottom \_\_\_\_\_ Total Depth of Well 4075 Feet  
Show depth and thickness of all water, oil and gas formations.

OIL, GAS OR WATER RECORDS

CASING RECORD

FORMATION	CONTENT	FROM	TO	SIZE	PUT IN	PULLED OUT
				8 5/8"	1057'	-0-

Describe in detail the manner in which the well was plugged, indicating where the mud fluid was placed and the method or methods used in introducing it into the hole. If cement or other plugs were used, state the character of same and depth placed, from \_\_\_\_\_ feet to \_\_\_\_\_ feet for each plug set.

Filled hole/w mud to 260' plug w/25 SX. Cement mud to 40' bridge plug w/10 sx cement.

12-16-1971

RECEIVED  
STATE CORPORATION COMMISSION  
DEC 16 1971  
CONSERVATION DIVISION  
Wichita, Kansas

(If additional description is necessary, use BACK of this sheet)

Name of Plugging Contractor Leben Drilling, Inc.  
Address 100 Park Ave. Bldg. Oklahoma City, Oklahoma 73102

STATE OF \_\_\_\_\_, COUNTY OF \_\_\_\_\_, SS.  
\_\_\_\_\_  
(employee of owner) or (owner or operator) of the above-described well, being first duly sworn on oath, says: That I have knowledge of the facts, statements, and matters herein contained and the log of the above-described well as filed and that the same are true and correct. So help me God.

(Signature) Leslie Kate

SUBSCRIBED AND SWORN TO before me this 13th day of December, 19 71

My commission expires 7-26-72

(Address) \_\_\_\_\_  
W. J. Miller  
Notary Public.

WELL LOG

15-145-20234-0000

Company Leben Oil Corporation

Sec. 12 T.22S R. 17W

Contractor Leben Drilling, Inc.

Loc. C NW SW

Farm Smith #1

County Pawnee County


Total Depth 4075'

Casing 8 5/8"

Commenced November 29, 1971

Production

Completed December 7, 1971

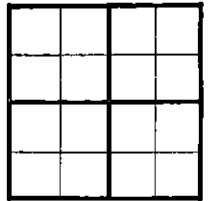

Figures Indicate Bottom of Formations

- 0' - 20' clay
- 20' - 140' clay & sand
- 140' - 475' shale & sand
- 475' - 575' sand
- 575' - 715' shale
- 715' - 1046' red bed & shale
- 1046' - 1078' anhy
- 1078' - 2375' shale & lime
- 2375' - 2548' lime & shale
- 2548' - 3080' shale & lime
- 3080' - 3375' lime & shale
- 3375' - 3963' lime
- 3963' - 3985' lime & chert
- 3985' - 4006' lime
- 4006' - 4024' simpson
- 4024' - 4042' lime
- 4042' - 4075' lime & shale

RECEIVED  
 STATE CORPORATION COMMISSION  
 DEC 16 1971  
 CONSERVATION DIVISION  
 Wichita, Kansas

State of Oklahoma }  
 County of Oklahoma } SS

I, Leslie Kite of Leben Drilling, Inc., upon oath state that the above and foregoing is a true and correct copy of the log of the Smith #1 Well.

Leslie Kite

Subscribed and sworn to before me this 13th day of December, 197

My Commission Expires: 7-26-72 W. G. Gilbert