

WELL PLUGGING RECORD


STATE OF KANSAS  
STATE CORPORATION COMMISSION

Give All Information Completely  
Make Required Affidavit  
Mail or Deliver Report to:  
Conservation Division  
State Corporation Commission  
800 Biting Building  
Wichita, Kansas

FORMATION PLUGGING RECORD

Strike out upper line  
when reporting plugging  
off formations.

Pawnee County. Sec. 4 Twp 22-S. Rge. 17 (E) W. (W)  
Location as "NE 1/4 NW 1/4 SW 1/4" or footage from lines SW SW NW  
Lease Owner The Vickers Petroleum Co., Inc.  
Lease Name Frizell Well No. 1  
Office Address 201 W-K-H Bldg., Wichita, Kansas  
Character of Well (completed as Oil, Gas or Dry Hole) Dry  
Date well completed March 27 1949  
Application for plugging filed March 27 1949  
Application for plugging approved March 27 1949  
Plugging commenced March 28 1949  
Plugging completed March 28 1949  
Reason for abandonment of well or producing formation Dry

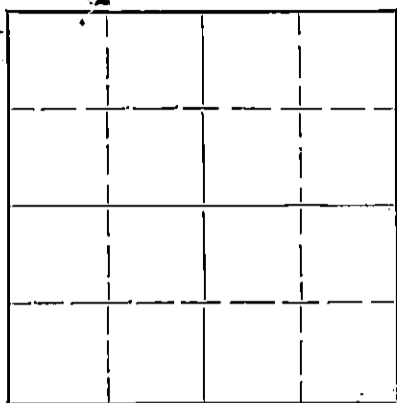

Locate well correctly on above  
Section Plat

If a producing well is abandoned, date of last production 19  
Was permission obtained from the Conservation Division or its agents before plugging was commenced? Yes

Name of Conservation Agent who supervised plugging of this well C. D. Stough, Great Bend  
Producing formation Arbuckle Depth to top 3979 Bottom 4040 Total Depth of Well 4040 Feet  
Show depth and thickness of all water, oil and gas formations.

OIL, GAS OR WATER RECORDS

CASING RECORD

Formation	Content	From	To	Size	Put In	Pulled Out
				8-5/8"	1064'	None

Describe in detail the manner in which the well was plugged, indicating where the mud fluid was placed and the method or methods used in introducing it into the hole. If cement or other plugs were used, state the character of same and depth placed, from feet to feet for each plug set.

Set plug @ 200'. Ran 15 sx cement on top of plug. Filled w/ mud to 30'. Set plug.  
Ran 10 sx cement on top of plug.

3-31-49

RECORDED  
MAR 31 1949  
STATE CORPORATION COMMISSION  
KANSAS

(If additional description is necessary, use BACK of this sheet)

Correspondence regarding this well should be addressed to The Vickers Petroleum Co., Inc.  
Address 201 W-K-H Bldg., Wichita, Kansas

STATE OF Kansas, COUNTY OF Sedgwick, ss.

H. C. Davis (employee of owner) or (agent) of the above-described well,  
being first duly sworn on oath, says: That I have knowledge of the facts, statements, and matters herein contained and the log of the above-described well as filed and that the same are true and correct. So help me God.

(Signature) H. C. Davis

201 W-K-H Bldg., Wichita, Kansas (Address)

SUBSCRIBED AND SWORN to before me this 29th day of March, 1949

Allen J. Denton  
Notary Public.

My commission expires August 13, 1949

22-2625  
PLUGGING  
FILE SEC 4 T 27 R 26  
BOOK PAGE 27 LINE 1

## THE VICKERS PETROLEUM CO., INC.

Frizell Well #1  
SW SW NW 4-22S-17W  
Pawnee County, Kansas

Casing Record:  
8-5/8" @ 1064' w/ 450 sz

Commenced: March 11, 1949  
Completed: March 28, 1949

Elevation: 2033 R.B.  
D & A

LOG

Surface	0-20
Sand & Shale	20-110
Shale & Shells	110-375
Red Bed & Shale	375-450
Shale & Shells	450-480
Sand	480-810
Red Bed	810-1060
Anhydrite	1060-1085
Red Bed & Shale	1085-1360
Shale & Red Bed & Shells	1360-1455
Salt & Shale	1455-1635
Shale & Lime	1635-1915
Lime Broken	1915-1940
Lime & Sand	1940-2205
Lime Broken	2205-2255
Lime & Sand	2255-2290
Lime & Shale	2290-2430
Lime Broken	2430-2515
Lime & Shale	2515-3015
Lime	3015-3497
Sand & Shale	3497-3560
Lime & Shale	3560-3569
Lime	3569-3855
Lime & Shale	3855-3924
Shale w/ Lime Streaks	3924-3945
Shale Weathered	3945-3974
Shale & Sand	3974-3979
Dolomite	3979-4040 T.D.

D &amp; A

Tops:	
Heebner	3467
Base Oread	3497
Brown Lansing	3560
White Lansing	3569
Simpson	3974
Arbuckle	3979

I hereby certify that this log is true and correct to the best of my knowledge and belief.

THE VICKERS PETROLEUM CO., INC.

By H. C. Davis

Subscribed and sworn to before me  
this 29th day of March, 1949.

Allen Denton  
Notary Public

My commission expires August 13, 1949.

