


STATE OF KANSAS
STATE CORPORATION COMMISSION

WELL PLUGGING RECORD

Give All Information Completely
Make Required Affidavit
Mail or Deliver Report to:
Conservation Division
State Corporation Commission
211 No. Broadway
Wichita, Kansas

PAWNEE County. Sec. 16 Twp. 22S Rge. 15W (E) (W)
Location as "NE/CNW%SW%" or footage from lines C SW SW
Lease Owner Kern Drilling Company, Inc.
Lease Name Koehn Well No. 1
Office Address 337 Union Center, Wichita, Kansas 67202
Character of Well (completed as Oil, Gas or Dry Hole) Dry Hole
Date well completed April 3 19 66
Application for plugging filed April 3 19 66
Application for plugging approved April 3 19 66
Plugging commenced April 3 19 66
Plugging completed April 3 19 66
Reason for abandonment of well or producing formation Dry Hole

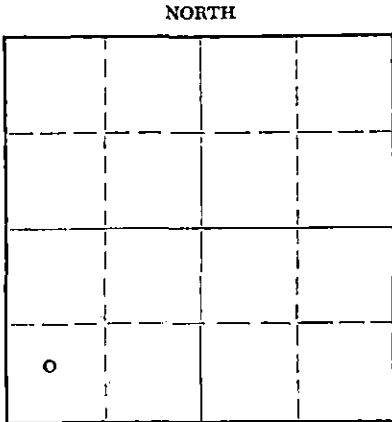

NORTH
Locate well correctly on above Section Plat

If a producing well is abandoned, date of last production 19
Was permission obtained from the Conservation Division or its agents before plugging was commenced? Yes

Name of Conservation Agent who supervised plugging of this well Leo Massey, Box 582, Hays, Kansas
Producing formation Depth to top Bottom Total Depth of Well Feet
Show depth and thickness of all water, oil and gas formations.

OIL, GAS OR WATER RECORDS

CASING RECORD

FORMATION	CONTENT	FROM	TO	SIZE	PUT IN	PULLED OUT
		0	243	8 5/8"	243	None

Describe in detail the manner in which the well was plugged, indicating where the mud fluid was placed and the method or methods used in introducing it into the hole. If cement or other plugs were used, state the character of same and depth placed, from feet to feet for each plug set.

Set Plug: 540'/25 sacks cement
240'/20 sacks cement
40'/10 sacks cement

4-11-1966
RECEIVED
STATE CORPORATION COMMISSION

APR 11 1966

CONSERVATION DIVISION
Wichita, Kansas

(If additional description is necessary, use BACK of this sheet)

Name of Plugging Contractor Hellar Drilling Company, Inc.
Address Wichita, Kansas 1014 Union Center 67202

STATE OF Kansas, COUNTY OF Sedgwick, ss.

D. L. Hellar, Pres. of Hellar Drilling Co. Inc. (Employee of owner) or (owner or operator) of the above-described well, being first duly sworn on oath, says: That I have knowledge of the facts, statements, and matters herein contained and the log of the above-described well as filed and that the same are true and correct. So help me God.

(Signature) D. L. Hellar, President

1014 Union Center, Wichita, Kansas 67202
(Address)

SUBSCRIBED AND SWORN TO before me this 8th day of April, 19 66

My commission expires March 25, 1968.

Catherine Darcey - Notary Public.

DRILLER'S LOG

COMPANY: Kern Drilling Company, Inc.
 337 Union Center, Wichita, Kansas
 CONTRACTOR: Hellar Drilling Company, Inc.
 LEASE: #1 Koehn
 LOCATION: C SW SW 16-22S-15W, Pawnee County, Kansas
 COMMENCED: March 24, 1966
 COMPLETED: April 3, 1966
 CASING: Set 8 5/8" surface casing @ 243'/200 sacks cement.

0-243	Shale
243-790	Shale & Red Bed & Sand streaks
790-960	Red Bed
960-984	Anhydrite
984-1665	Red Bed, shale w/sand streaks
1665-1838	Shale & Red Bed
1838-1957	Chert & lime
1957-2107	Lime & Shale
2107-2268	Chert & Lime
2268-2420	Shale & Lime
2420-3139	Lime & Shale
3139-3245	Lime
3245-3385	Shale & Lime
3385-3481	Lime & shale
3481-3536	Shale
3536-3541	Br. Lime
3541-3544	Shale
3544-3583	Lsg. lime
3583-3727	Lime
3727-3780	K. C. Lime
3780-3886	Lime & Shale
3886-3918	Cong. shale & chert
3918-3945	Lime & sandy chert
3945-3975	Shale & chert
3975-4010	Lime & chert
4010-4059	Dolomite
4059	Rotary Total Depth

RECEIVED
 STATE CORPORATION COMMISSION
 APR 11 1966
 CONSERVATION DIVISION
 Wichita, Kansas

Dry & Abandoned

STATE OF KANSAS)
) ss
 COUNTY OF SEDGWICK)

I, D. L. Hellar, do hereby certify that the above and foregoing is a true and correct copy of the log of the #1 Koehn, located in C SW SW Sec. 16-22S-15W, Pawnee County, Kansas, as reflected by the files of the Hellar Drilling Company, Inc.

HELLAR DRILLING COMPANY, INC.

By *D. L. Hellar*
 President - D. L. Hellar

Subscribed and sworn to before me, a Notary Public, in and for Sedgwick County, Kansas, this 8th day of April, 1966.

My Commission Expires:
 March 25, 1968

Catherine Darcey
 Notary Public - Catherine Darcey