

STATE OF KANSAS  
STATE CORPORATION COMMISSION


WELL PLUGGING RECORD

Give All Information Completely  
Make Proper Affidavit  
Mail or Deliver Report to:  
Conservation Division  
State Corporation Commission  
800 Bittling Building  
Wichita, Kansas

OR  
FORMATION PLUGGING RECORD

Strike out upper line  
when reporting plug-  
ging off formations.

NORTH

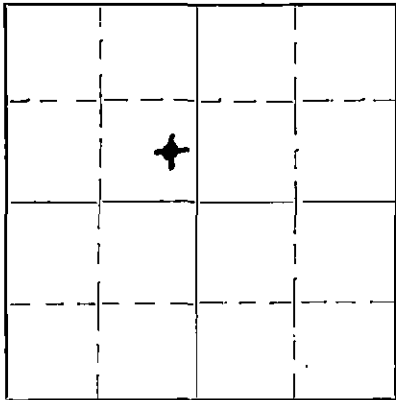

Locate well correctly on above  
Section Plat

Pawnee County. Sec. 15 Twp. 22 Rge. (E) 15 (W)

Location as "NE 1/4 NW 1/4 SW 1/4" or footage from lines Center 1/2 SE 1/2 NW 1/2

Lease Owner The Atlantic Refining Co.

Lease Name J.R. Wrattil Well No. 1

Office Address Box 17, Great Bend, Kansas.

Character of Well (completed as Oil, Gas or Dry Hole) Dry Hole

Date, well completed 193

Application for plugging filed Jan. 13, 1941. 193

Application for plugging approved Jan. 13, 1941. 193

Plugging Commenced Jan. 13, 1941. 193

Plugging Completed Jan. 14, 1941. 193

Reason for abandonment of well or producing formation Dry hole

If a producing well is abandoned, date of last production 193

Was permission obtained from the Conservation Division or its agents before plugging was commenced? Yes

Name of Conservation Agent who supervised plugging of this well C.T. Alexander

Producing formation None Depth to top Bottom Total Depth of Well 4009 Feet

Show depth and thickness of all water, oil and gas formations.

OIL, GAS OR WATER RECORDS

CASING RECORD

Formation	Content	From	To	Size	Put In	Pulled Out
Arbuckle	Water	3986	4009 TD	13"	368'	None

Describe in detail the manner in which the well was plugged, indicating where the mud fluid was placed and the method or methods used in introducing it into the hole. If cement or other plugs were used, state the character of same and depth placed, from feet to feet for each plug set.

Cement Plug of 30 sacks placed from 3990 to 3928  
 Rotary Mud " " 3928 " 365  
 Cement Plug of 12 sacks " " 365 " 350  
 Rotary Mud " " 350 " 14  
 Cement Plug of 8 sacks " " 14 " 6

PLUGGING  
 FILE SEC 15 22 15W  
 BOOK PAGE 127 LINE 3

JAN 23 1941  
 STATE CORP. COM.  
 WICHITA, KANS.  
 1-22-1941

(If additional description is necessary, use BACK of this sheet)

Correspondence regarding this well should be addressed to The Atlantic Refining Company.

Address Box 17, Great Bend, Kansas.

STATE OF Kansas, COUNTY OF Barton, ss.

P.B. Edmondson (employee of owner) or (owner or operator) of the above-described well,

being first duly sworn on oath, says: That I have knowledge of the facts, statements, and matters herein contained and the log of the above-described well as filed and that the same are true and correct. So help me God.

(Signature) P.B. Edmondson

(Address)

SUBSCRIBED AND SWORN to before me this 16 day of January, 1941

My commission expires Oct. 28, 1944

H.C. Colagrosso Notary Public.



## FORMATION RECORD

Give detailed description and thickness of all formations drilled through and contents of sand, whether dry, water, oil or gas

Formation	Top	Bottom	Formation	Top	Bottom
Sand	0	45			
Sand and clay	45	150			
Sand and shale	150	360			
Red bed	360	375			
Red bed	375	390			
Sandy shale	390	490			
Sand	490	560			
Red bed	560	1100			
Red bed and shale	1100	1114			
Red bed and shale	1114	1214			
Shale and shells	1214	1765			
Lime	1765	1970			
Broken lime	1970	2033			
Lime	2033	2100			
Broken lime	2100	2382			
Lime	2382	2472			
Broken lime	2472	2620			
Shale	2620	2680			
Broken lime	2680	2918			
Lime and shale	2918	3011			
Shale	3011	3108			
Broken lime	3108	3417			
Shale	3417	3536			
K. C. Lime	3536	3552			
K. C. Lime	3552	3736			
Broken lime	3736	3799			
Lime	3799	3829			
Shale	3829	3865			
Conglomerate	3865	3903			
Thin lime and Chert	3903	3938			
Sandy shale	3938	3980			
Shale	3980	3985			
Arbuckle	3985	4009 T.D.			
PLUGGING COMMENCED January 13, 1941					
PLUGGING COMPLETED January 14, 1941					
Cement plug of 30 sacks placed from 3990 to 3928					
Rotary mud " " 3928 to 365					
Cement plug of 12 sacks " " 365 to 350					
Rotary mud " " 350 to 14					
Cement plug of 8 sacks " " 14 to 6					

