


WELL PLUGGING RECORD

Give All Information Completely  
Make Required Affidavit  
Mail or Deliver Report to:  
Conservation Division  
State Corporation Commission  
211 No. Broadway  
Wichita, Kansas

Pawnee County. Sec. 15 Twp. 22 Rge.      (E) 15 (W)  
Location as "NE/CNW/SE/SW" or footage from lines C NW SE/4  
Lease Owner Woodman & Iannitti Drilling Co.  
Lease Name      Lovett Well No. 2  
Office Address 706 Union National Bldg., Wichita, Kansas  
Character of Well (completed as Oil, Gas or Dry Hole) Dry Hole  
Date well completed Jan. 18 1965 66  
Application for plugging filed Jan. 18 1965 66  
Application for plugging approved Jan. 18 1965 66  
Plugging commenced Jan. 18 1965 66  
Plugging completed Jan. 18 1965 66  
Reason for abandonment of well or producing formation Dry

NORTH

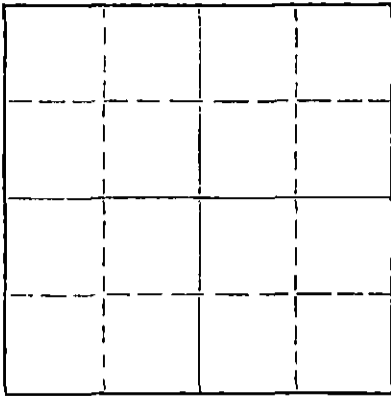

Locate well correctly on above  
Section Plat

If a producing well is abandoned, date of last production      19      
Was permission obtained from the Conservation Division or its agents before plugging was commenced? Yes

Name of Conservation Agent who supervised plugging of this well Eldon Petty  
Producing formation      Depth to top      Bottom      Total Depth of Well 3713 Feet  
Show depth and thickness of all water, oil and gas formations.

OIL, GAS OR WATER RECORDS

CASING RECORD

FORMATION	CONTENT	FROM	TO	SIZE	PUT IN	PULLED OUT
				8 5/8	207'	

Describe in detail the manner in which the well was plugged, indicating where the mud fluid was placed and the method or methods used in introducing it into the hole. If cement or other plugs were used, state the character of same and depth placed, from      feet to      feet for each plug set.

Bottom Plug @ 200' w/25 sx  
Top Plug @ 40' w/10 sx.

RECEIVED  
STATE CORPORATION COMMISSION

JAN 24 1966

CONSERVATION DIVISION  
Wichita, Kansas

(If additional description is necessary, use BACK of this sheet)  
Name of Plugging Contractor Woodman & Iannitti Drilling Co.  
Address 706 Union Nat'l. Bldg., Wichita, Kansas

STATE OF Kansas, COUNTY OF Sedgwick, ss.  
K. T. Woodman (employee of owner) or (owner or operator) of the above-described

well, being first duly sworn on oath, says: That I have knowledge of the facts, statements, and matters herein contained and the log of the above-described well as filed and that the same are true and correct. So help me God.

(Signature) K. T. Woodman  
K. T. Woodman 706 Union Nat'l. Bldg.  
(Address)

SUBSCRIBED AND SWORN to before me this 21 day of January, 19 66

My commission expires Feb. 11, 1968

Justina Chamberlain  
Justina Chamberlain Notary Public.

15-145-30092-0000

KANSAS GEOLOGICAL SOCIETY  
KANSAS WELL LOG BUREAU - KANSAS WELL SAMPLE BUREAU  
KANSAS GEOLOGICAL SOCIETY BUILDING  
508 EAST MURDOCK - WICHITA, KANSAS

COMPANY Woodman & Iannitti Drilling Co.

SEC. 15 T. 22 R. 15W


FARM Lovett NO. 2

LOC. C NW SE/4

TOTAL DEPTH 3713'  
COMM. January 10-66 COMP. January 18-66  
SHOT OR TREATED  
CONTRACTOR Woodman & Iannitti Drilling Co.  
ISSUED

COUNTY Pawnee

KANSAS

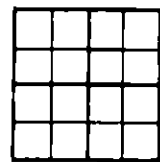

CASING  
20 10  
15 8 5/8 @ 207' w/185 sx  
12 6  
13 5

ELEVATION 1989 KB

PRODUCTION D & A

FIGURES INDICATE BOTTOM OF FORMATIONS

75 Sand  
210 Shale  
420 Red Bed & Shale  
490 Sand  
932 Red Bed  
960 Anhy  
1065 Shale  
1710 Shale & Shells  
1800 Shale & Shells  
1880 Lime  
2080 Lime  
2230 Lime  
2260 Lime  
2350 Shale & Lime  
2505 Lime  
2690 Lime & Shale  
2835 Lime & Shale  
2845 Shale & Lime  
3070 Lime  
3145 Lime  
3235 Lime  
3350 Lime  
3420 Lime  
3505 Lime & Shale  
3605 Lime  
3680 Lime  
3713 Lime  
3713 Total Depth

RECEIVED  
STATE CORPORATION COMMISSION

JAN 24 1966

CONSERVATION DIVISION  
Wichita, Kansas

I certify the above to be a true and correct copy of the driller's log and the geological tops to the best of my knowledge and belief.

*K. T. Woodman*  
K. T. Woodman