


STATE OF KANSAS
STATE CORPORATION COMMISSION

WELL PLUGGING RECORD

Give All Information Completely
Make Required Affidavit
Mail or Deliver Report to
Conservation Division
State Corporation Comm.
245 North Water
Wichita, KS 67202

Pawnee County. Sec. 14 Twp. 22S Rge. 15W E/W
Location as "NE/CNW/SW" or footage from lines
C NW NE

Lease Owner Big J Production Co.
Lease Name Standish Well No. B-1
Office Address 427 N. St. Francis Wichita, Kansas 67802
Character of Well (Completed as Oil, Gas or Dry Hole) Dry Hole

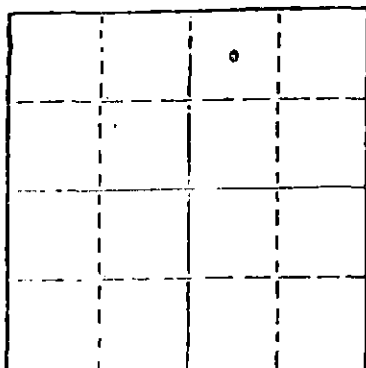

Locate well correctly on above
Section Plot

Date Well completed 1-3-82 19
Application for plugging filed 1-3-82 19
Application for plugging approved 1-3-82 19
Plugging commenced 1-3-82 19
Plugging completed 1-3-82 19
Reason for abandonment of well or producing formation _____

If a producing well is abandoned, date of last production _____ 19

Was permission obtained from the Conservation Division or its agents before plugging was commenced? Yes

Name of Conservation Agent who supervised plugging of this well Steve Durrant
Producing formation _____ Depth to top _____ Bottom _____ Total Depth of Well 4050
Show depth and thickness of all water, oil and gas formations.

OIL, GAS OR WATER RECORDS

CASING RECORD:

FORMATION	CONTENT	FROM	TO	SIZE	PUT IN	PULLED OUT

Describe in detail the manner in which the well was plugged, indicating where the mud fluid was placed and the method or methods used in introducing it into the hold. If cement or other plugs were used, state the character of same and depth placed, from _____ feet to _____ feet for each plug set.

Mud From Bottom To 720' 70 Sacks 50-50 Posmix 4% Gel 3% CC
Mud To 510 40 Sacks 50-50 Posmix 4% Gel 3% CC
Mud To 40' 10 Sacks 50-50 Posmix 4% Gel 3% CC
5 Sacks In Rat Hole
5 Sacks In Mouse Hole
5 Sacks In Water Well

(If additional description is necessary, use BACK of this sheet)

Name of Plugging Contractor Merckle Drilling Co.

STATE OF Kansas COUNTY OF Barton, ss.
Clyde Merckle (employee of owner) or (owner or operator)


of the above-described well, being first duly sworn on oath, says: That I have knowledge of the facts, statements, and matters herein contained and the log of the above-described well as filed and that the same are true and correct. So help me God.

(Signature) Clyde Merckle
Box 1382 Great Bend, Kansas 67530
(Address)

SUBSCRIBED AND SWORN TO before me this 6th day of January, 19 82

My commission expires 3-28-84

Loretta Notary Public.
RECEIVED
STATE CORPORATION COMMISSION

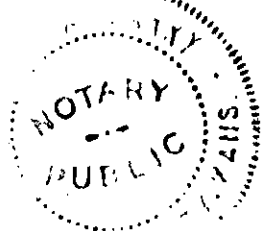

JAN - 8 1982
CONSERVATION DIVISION
Wichita, Kansas

Big J Production Company
427 N. St. Francis
Wichita, Kansas 67202

Standish B1

C NW NE Section 14 Twp. 22 Rge. 15W

Pawnee County

Driller's Log _____ Total Depth 4050

0-----100 Sand

100----380 Shale & Lime Shells

380----410 Red Bed

410----477 Sand

477----541 Red Bed

541----926 Red Bed

926----950 Anhydrite

950----1650 Shale

1650---2375 Shale

2375---3110 Shale & Lime

3110---3540 Shale & Lime

3540---3850 Lime

3850---4050 Lime


Clyde Merckle