


STATE OF KANSAS  
STATE CORPORATION COMMISSION

Form CP-4

Give All Information Completely  
Make Required Affidavit  
Mail or Deliver Report to:  
Conservation Division  
State Corporation Commission  
212 No. Market  
Wichita, Kansas

WELL PLUGGING RECORD

NORTH

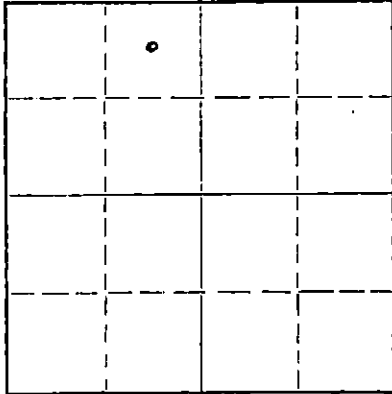

Locate well correctly on above  
Section Plot

Hodgeman County. Sec. 30 Twp. 22 Rge. 23W (~~25E~~) (W)  
Location as "NE/CNW/SW" or footage from lines C NE NW  
Lease Owner Imperial Oil of Kansas, Inc.  
Lease Name Hayes Core Hole # 59 Well No. 1  
Office Address 780 4th Nat'l Bldg., Wichita, Kansas  
Character of Well (completed as Oil, Gas or Dry Hole) COREHOLE  
Date well completed \_\_\_\_\_ 19\_\_\_\_  
Application for plugging filed \_\_\_\_\_ 19\_\_\_\_  
Application for plugging approved \_\_\_\_\_ 19\_\_\_\_  
Plugging commenced \_\_\_\_\_ 19\_\_\_\_  
Plugging completed January 11, 19 60  
Reason for abandonment of well or producing formation \_\_\_\_\_

If a producing well is abandoned, date of last production \_\_\_\_\_ 19\_\_\_\_  
Was permission obtained from the Conservation Division or its agents before plugging was commenced? yes

Name of Conservation Agent who supervised plugging of this well Frank Broadfoot  
Producing formation \_\_\_\_\_ Depth to top \_\_\_\_\_ Bottom \_\_\_\_\_ Total Depth of Well 2785' Feet  
Show depth and thickness of all water, oil and gas formations.

OIL, GAS OR WATER RECORDS

CASING RECORD

FORMATION	CONTENT	FROM	TO	SIZE	PUT IN	PULLED OUT

Describe in detail the manner in which the well was plugged, indicating where the mud fluid was placed and the method or methods used in introducing it into the hole. If cement or other plugs were used, state the character of same and depth placed, from \_\_\_\_\_ feet to \_\_\_\_\_ feet for each plug set.

No Surface Pipe  
Filled hole with mud - spotted 20 sacks cement  
through drill pipe 500' to 440' - spotted 20 sacks  
cement 200' to 140' - capped 4' below surface with  
10 sacks cement.

RECEIVED  
STATE CORPORATION COMMISSION

FEB 17 1966

CONSERVATION DIVISION  
Wichita, Kansas

(If additional description is necessary, use BACK of this sheet)  
Name of Plugging Contractor Company Tools  
Address \_\_\_\_\_

STATE OF Kansas, COUNTY OF Sedgewick, ss.

(employee of owner) or (owner or operator) of the above-described well, being first duly sworn on oath, says: That I have knowledge of the facts, statements, and matters herein contained and the log of the above-described well as filed and that the same are true and correct. So help me God.

(Signature) [Signature]  
780 4th Nat'l Bldg., Wichita, Kansas  
(Address)

SUBSCRIBED AND SWORN TO before me this 11<sup>th</sup> day of February, 1966  
Seward D. Greider  
Notary Public.

My commission expires 11-8-67

*[Signature]*  
DRILLER'S LOG

Imperial Oil of Kansas, Inc.  
780 Fourth National Bldg.  
Wichita 2, Kansas

RECEIVED  
STATE CORP  
DIVISION

MAR 22 1960

CONSERVATION DIVISION  
Wichita, Kansas

Core-Hole #59  
Hays #1  
C NE NW Sec. 30-22S-23W  
Hodgeman County, Kansas

Commenced: 1-7-60 Completed: 1-11-60  
Contractor: Imperial Oil of Kansas, Inc.  
Rig #3

Elevation: 2382' K.B.  
Total Depth: 2785'  
Results: Plugged

Figures indicate bottom of formations:

		<u>TOPS</u>	
Surface Clay & Sand	130'		
Shale	990'	Anhydrite	1635' (-747)
Shale, Sand & Redbed	1624'	Ft. Riley	2716' (-334)
Anhydrite	1658'	Total Depth	2785' (-403)
Shale & Shells	2405'		
Shale & Lime	2785'		
Total Depth	2785'		

We hereby certify this to be a correct and accurate log of the above described well, as shown on the Daily Drilling Reports.

IMPERIAL OIL OF KANSAS, INC.

By: *K. J. Boone*  
K. J. Boone, Pet. Engr.

Subscribed and sworn to before me this 18th day of March, 1960

My Commission Expires: July 7, 1962

*Mona L. Latier*  
Mona L. Latier - Notary Public