

RECEIVED
STATE CORPORATION COMMISSION

NOV 6 1974

CONSERVATION DIVISION
Wichita, Kansas

FORM CP-4

STATE OF KANSAS
STATE CORPORATION COMMISSION
CONSERVATION DIVISION
P. O. BOX 17027
WICHITA, KANSAS 67217

WELL PLUGGING RECORD

Hodgeman County, Sec. 30 Twp. 22S Rge. (E) 23 (W)

Location as "NE/CNW/SW" or footage from lines NE NW NW

Lease Owner Parrish Oil Company

Lease Name Hays Well No. 1 "A"

Office Address 714 Fourth Nat'l Bank Bldg., Wichita, Kansas

Character of Well (completed as Oil, Gas or Dry Hole) oil 67202

Date well completed 19

Application for plugging filed Oct. 17 19 74

Application for plugging approved 19


Plugging commenced Oct. 28 19 74

Plugging completed Nov. 4 19 74

Reason for abandonment of well or producing formation depleted

If a producing well is abandoned, date of last production 19

Was permission obtained from the Conservation Division or its agents before plugging was commenced? yes

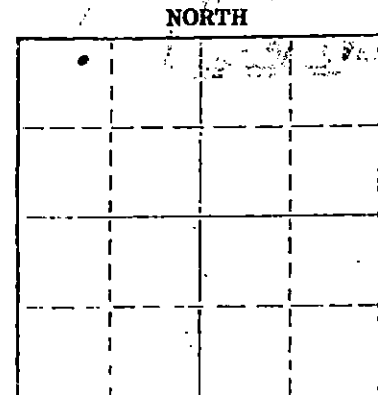

Locate well correctly on above Section Plat

Name of Conservation Agent who supervised plugging of this well Edgar Eves

Producing formation Depth to top Bottom Total Depth of Well 4715 Feet

Show depth and thickness of all water, oil and gas formations.

OIL, GAS OR WATER RECORDS

CASING RECORD

FORMATION	CONTENT	FROM	TO	SIZE	PUT IN	PULLED OUT
			294'	8 5/8"	294'	none
			4715'	5 1/2"	4715'	512.05

Describe in detail the manner in which the well was plugged, indicating where the mud fluid was placed and the method or methods used in introducing it into the hole. If cement or other plugs were used, state the character of same and depth placed, from feet to feet for each plug set.

Plugged bottom at 4100' with 4 sacks of cement.

Halliburton plugged well pumping in 2 sacks of hulls, 20 sacks of gel and 100 sacks of cement.

Name of Plugging Contractor PIPE PULLERS, INC. (If additional description is necessary, use BACK of this sheet)

Address Box 128, Ellinwood, Kansas 67526

STATE OF KANSAS COUNTY OF BARTON ss. Evelyn Roth

(employee of owner) or (owner or operator) of the above-described well, being first duly sworn on oath, says: That I have knowledge of the facts, statements, and matters herein contained and the log of the above-described well as filed and that the same are true and correct. So help me God.

(Signature) Evelyn Roth
Ellinwood, Kansas

SUBSCRIBED AND SWORN TO before me this 5th day of November, 1974

My commission expires

JENNY KASSELMAN
NOTARY PUBLIC
BARTON COUNTY, KANSAS
MY COMM. EXP. JULY 16, 1978

Jenny Kaselman
Notary Public.

DRILLER'S LOG

Imperial Oil of Kansas, Inc.
780 Fourth National Building
Wichita 2, Kansas

Hays "A" No. 1
NE NW NW Sec. 30-22S-23W
Hodgeman County, Kansas

Total Depth: 4715'

Elevation: 2380' R.B.
Production:

Commenced: 10-22-59 Completed: 11-7-59

Contractor: Imperial Oil of Kansas, Inc.
Wichita 2, Kansas

Casing Record: Set 8-5/8" Surface Pipe at 294' with 175 sacks cement.
Set 5-1/2" Production Pipe at 4715' with 100 sacks cement.

Figures indicate bottom of formations:

Clay, Sand & Shale	294'
Shale & Sand	1120'
Shale, Shells & Sand	1622'
Anhydrite	1665'
Shale & Shells	1935'
Shale	2175'
Shale & Shells	2410'
Shale & Lime	3545'
Lime	4615'
Cherty Lime	4715'
Total Depth	4715'

TOPS

Heebner	3940'	(-1560)
Toronto	3956'	(-1576)
Lansing	4017'	(-1637)
Cherokee	4534'	(-2154)
Mississippi	4641'	(-2261)
Rotary Total Depth	4715'	(-2335)

We hereby certify this to be a correct and accurate log of the above described well, as shown on the daily drilling reports.

IMPERIAL OIL OF KANSAS, INC.

By: *A. B. ...*
Vice-President

Subscribed and sworn to before me this 19th day of November, 1959.

My Commission Expires:

July 7, 1962

Mona L. Latier
Mona L. Latier - Notary Public