

TIGHT
HOLE

15-083-21250-0001

~~CONFIDENTIAL~~

STATE CORPORATION COMMISSION OF KANSAS
OIL & GAS CONSERVATION DIVISION
WELL COMPLETION FORM
ACO-1 WELL HISTORY
DESCRIPTION OF WELL AND LEASE

API NO. 15- 083-21,250-A

County Hodgeman

C SE NW Sec. 10 Twp. 22S Rge. 26 XX East West

3300' Ft. North from Southeast Corner of Section

3300' Ft. West from Southeast Corner of Section
(NOTE: Locate well in section plat below.)

Lease Name GLUNT Well # 1

Field Name wildcat

Producing Formation D & A

Elevation: Ground 2437 KB 2442

Total Depth 4590 PBD

Operator: License # 4569

Name: JAY BOY OIL, INC.

Address 224 E. Douglas, #425

City/State/Zip Wichita, KS 67202

Purchaser: N/A

Operator Contact Person: Gary Sharp

Phone (316) 264-3700

Contractor: Name: ALLEN DRILLING COMPANY

License: 5418

Wellsite Geologist:

Designate Type of Completion

New Well X Re-Entry Workover

Oil SWD Temp. Abd.

Gas Inj Delayed Comp.

X Dry Other (Core, Water Supply, etc.)

If OWM: old well info as follows:

Operator: True Oil Co.

Well Name: #22-10 Glunt

Comp. Date 4/11/86 old Total Depth 4590'

Drilling Method:

X Mud Rotary Air Rotary Cable

1/22/90 1/23/90 1/24/90

Spud Date Date Reached TD Completion Date


Amount of Surface Pipe Set and Cemented at Feet

Multiple Stage Cementing Collar Used? Yes No

If yes, show depth set Feet

If Alternate II completion, cement circulated from

feet depth to w/ sx cmt.

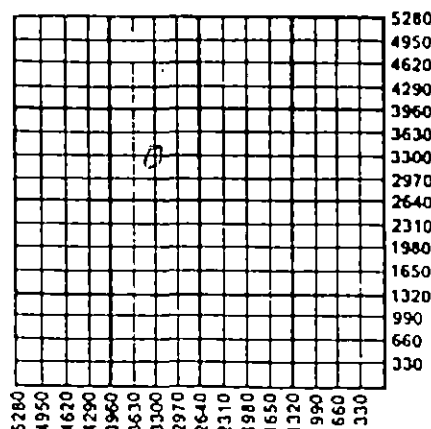

INSTRUCTIONS: This form shall be completed in triplicate and filed with the Kansas Corporation Commission, 200 Colorado Derby Building, Wichita, Kansas 67202, within 120 days of the spud date of any well. Rule 82-3-130, 82-3-107 and 82-3-106 apply. Information on side two of this form will be held confidential for a period of 12 months if requested in writing and submitted with the form. See rule 82-3-107 for confidentiality in excess of 12 months. One copy of all wireline logs and drillers time log shall be attached with this form. ALL CEMENTING TICKETS MUST BE ATTACHED. Submit CP-4 form with all plugged wells. Submit CP-111 form with all temporarily abandoned wells. Any recompletion, workover or conversion of a well requires filing of ACO-2 within 120 days from commencement date of such work.

All requirements of the statutes, rules and regulations promulgated to regulate the oil and gas industry have been fully complied with and the statements herein are complete and correct to the best of my knowledge.

Signature Joni M. Chlach

Title Operations Secretary Date May 30, 1990

Subscribed and sworn to before me this 30th day of May, 1990.

Notary Public Betty B. Herring

Date Commission Expires 10-07-93

COPY

BETTY B. HERRING
NOTARY PUBLIC
STATE OF KANSAS
My Appt. Exp. 10-07-93

K.C.C. OFFICE USE ONLY					
<input checked="" type="checkbox"/>	F	Letter of Confidentiality Attached			
<input type="checkbox"/>	C	Wireline Log Received			
<input type="checkbox"/>	C	Drillers Timelog Received			
Distribution					
<input type="checkbox"/>	KCC	<input type="checkbox"/>	SWD/Rep	<input type="checkbox"/>	NGPA
<input type="checkbox"/>	KGS	<input type="checkbox"/>	Plug	<input type="checkbox"/>	Other
(Specify)					

Form ACO-1 (7-89)