


STATE OF KANSAS
STATE CORPORATION COMMISSION
Give All Information Completely
Make Required Affidavit
Mail or Deliver Report to:
Conservation Division
State Corporation Commission
800 Bitting Building
Wichita, Kansas

WELL PLUGGING RECORD

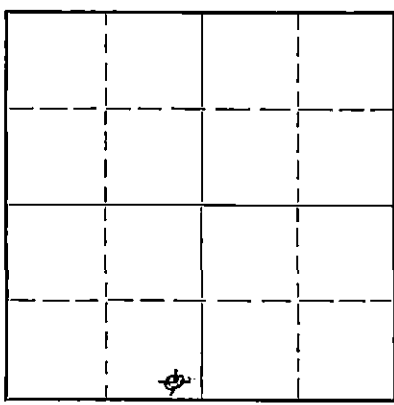

Locate well correctly on above Section Plat

Stafford County. Sec. 20. Twp. 22. Rge. 12. (E) (W)
Location as "NE/CNW $\frac{1}{4}$ SW $\frac{1}{4}$ " or footage from lines SE SE SW
Lease Owner John T. Harris
Lease Name Likens Well No. 1
Office Address Room 819, 600 S. Michigan, Chicago, Illinois
Character of Well (completed as Oil, Gas or Dry Hole) Dry hole
Date well completed October 18, 1950
Application for plugging filed October 18, 1950
Application for plugging approved October 18, 1950
Plugging commenced October 18, 1950
Plugging completed October 18, 1950
Reason for abandonment of well or producing formation Dry
If a producing well is abandoned, date of last production 19
Was permission obtained from the Conservation Division or its agents before plugging was commenced? Yes

Name of Conservation Agent who supervised plugging of this well C. D. Stough, Gt. Bend, Kansas
Producing formation Depth to top Bottom Total Depth of Well 3760 Feet
Show depth and thickness of all water, oil and gas formations.

OIL, GAS OR WATER RECORDS

CASING RECORD

Formation	Content	From	To	Size	Put In	Pulled Out
		0	270	8-5/8	270	0

Describe in detail the manner in which the well was plugged, indicating where the mud fluid was placed and the method or methods used in introducing it into the hole. If cement or other plugs were used, state the character of same and depth placed, from feet to feet for each plug set.

Filled hole with heavy mud to 270' of top.
Bottom plug set at 270', cemented w/15 sacks cement.
Hole filled with mud to within 35' fo top.
Top plug set at 35' and cemented w/10 sacks.
Cement within five feet of surface.

10-25-50

RECEIVED
STATE CORPORATION COMMISSION
OCT 25 1950
CONSERVATION DIVISION
Wichita

(If additional description is necessary, use BACK of this sheet)
Correspondence regarding this well should be addressed to Virginia Drilling Co., Inc.
Address 701 Brown Bldg., Wichita 2, Kansas

STATE OF Kansas, COUNTY OF Sedgwick, ss.
S. A. Murphy (employee of owner) or (owner or operator) of the above-described well,
being first duly sworn on oath, says: That I have knowledge of the facts, statements, and matters herein contained and the log of the above-described well as filed and that the same are true and correct. So help me God.

(Signature) SA Murphy
701 Brown Bldg., Wichita 2, Kansas
(Address)

SUBSCRIBED AND SWORN TO before me this 24th day of October, 1950

Ileg M Newman
Notary Public.

My commission expires March 15, 1954

PLUGGING
FILE SEC 701-27-RDW
BOOK PAGE 37 LINE 16

Well: Ukens No. 1
 Location: SE SE SW/4 Sec. 20-22-12, Stafford County, Kansas
 Company: John T. Harris
 Contractor: Virginia Drilling Co., Inc.
 Commenced: October 4, 1950
 Completed: October 18, 1950
 Total Depth: 3760
 Elevation: 1871 D.F.

FORMATION	DEPTH
Clay	0-65
Clay-snad	65-240
Shells	240-255
Red Bed	255-270
Shale	270-285
Red Bed	285-660
Anhydrite	660-685
Red Bed-shale-shells	685-1140
Red Bed-shale	1140-1200
Salt	1200-1385
Shale-shells	1385-1505
Shale-lime	1505-1875
Broken-sandy	1875-1955
Shale-lime	1955-2255
Shale-shells	2255-2315
Lime-shale	2315-2395
Shale-shells	2395-2485
Lime-shale	2485-2875
Broken lime	2875-2895
Lime	2895-3310
Lime-shale	3310-3342
Lansing	3342-3365
Lime	3365-3421
Shale-lime	3421-3460
Lime	3460-3577
Broken lime	3577-3610
Lime-shale	3610-3619
Viola Chert	3619-3650
Cherty Lime	3650-3685
Lime-shale	3685-3747
Lime	3747-3760

Set 8-5/8" csg. @ 270'

TOPS:

Lansing	3342
Conglomerate	3605
Viola	3619
Simpson	3682
Arbuckle	3743

RECEIVED
 STATE CORPORATION COMMISSION
 OCT 25 1950
 CONSERVATION DIVISION
 Wichita, Kansas

Now comes S. A. Murphy, who states that he is familiar with the drilling of oil and gas wells and knows of his own knowledge that the Ukens #1 located in the SE SE SW/4 Sec. 20-22-12, Stafford County, Kansas, was drilled to a total depth of 3760 feet. Same was plugged and abandoned.

S. A. Murphy

Subscribed and sworn to before me this 24th day of October, 1950.

Inez M. Newman

My commission expires March 15, 1954.

PLUGGING
 LINE 37-22-12
 BOOK PAGE 37-LINE 16