


WELL PLUGGING RECORD

- Give All Information Completely
- Make Request Affidavit
- Mail or Deliver Report to:
- Conservation Division
- State Corporation Commission
- 212 No. Market
- Wichita, Kansas

NORTH

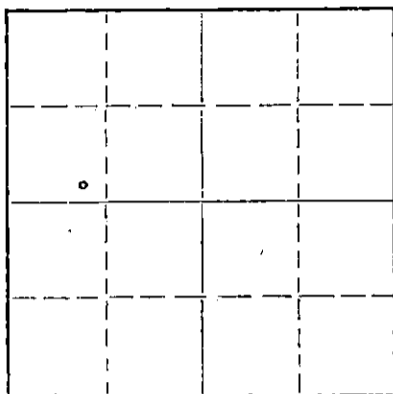

Locate well correctly on above Section Plat

Reno County. Sec. 8 Twp. 22 Rge. (E) 9 (W)
 Location as "NE/CNW/SW" or footage from lines SE SW NW
 Lease Owner McAdams Pipe & Supply Company
 Lease Name Brown Well No. 2
 Office Address Drawer 960, Bristow, Oklahoma
 Character of Well (completed as Oil, Gas or Dry Hole) oil
 Date well completed 19____
 Application for plugging filed Sept. 26 19 67
 Application for plugging approved 19____
 Plugging commenced October 9 19 67
 Plugging completed October 17 19 67
 Reason for abandonment of well or producing formation depleted

If a producing well is abandoned, date of last production 19____
 Was permission obtained from the Conservation Division or its agents before plugging was commenced? YES

Name of Conservation Agent who supervised plugging of this well Gilbert Toman
 Producing formation _____ Depth to top _____ Bottom _____ Total Depth of Well 3638 Feet
 Show depth and thickness of all water, oil and gas formations.

OIL, GAS OR WATER RECORDS

CASING RECORD

| FORMATION | CONTENT | FROM | TO | SIZE | PUT IN | PULLED OUT |
|-----------|---------|------|-------|--------|--------|------------|
| | | 0 | 210' | 8 5/8" | 210' | none |
| | | 0 | 3635' | 5 1/2" | 3635' | 3192.34 |
| | | | | | | |
| | | | | | | |
| | | | | | | |
| | | | | | | |

Describe in detail the manner in which the well was plugged, indicating where the mud fluid was placed and the method or methods used in introducing it into the hole. If cement or other plugs were used, state the character of same and depth placed, from _____ feet to _____ feet for each plug set.

Sand back to 3630' and dumped 5 sacks of cement.

Set 10' rock bridge at 225' and dumped 17 sacks of cement. Let set until 10-17-67. Bailed hole down to 190' and dumped 8 sacks of cement. Filled hole with mud to 40', set 10' rock bridge and capped well with 10 sacks of cement.

NOV 3 1967
 CONSERVATION DIVISION
 WICHITA, KANSAS

(If additional description is necessary, use BACK of this sheet)
 Name of Plugging Contractor Pipe Pullers, Inc.
 Address Box 486, Ellinwood, Kansas

STATE OF Kansas COUNTY OF Barton, ss.
 Dean Wells (employee of owner) or (owner or operator) of the above-described well, being first duly sworn on oath, says: That I have knowledge of the facts, statements, and matters herein contained and the log of the above-described well as filed and that the same are true and correct. So help me God.

(Signature) *Dean Wells*

Ellinwood, Kansas

(Address)

SUBSCRIBED AND SWORN to before me this 30th day of October, 1967

My commission expires Feb. 10, 1971

George A. Meyer
 Notary Public

WELL LOG BUREAU—KANSAS GEOLOGICAL SOCIETY
500 East Murdock, Wichita, Kansas

15-155-02419-0000

Company- **CHARLES RITCHIE**
Farm- Brown No. 2

SEC. 8 T. 22 R. 9W
SE SW NW

Total Depth. 3638'
Comm. 8-18-59 Comp. 8-28-59
Shot or Treated.
Contractor. White & Ellis Drlg
Issued. 6-17-61

County Reno KANSAS



CASING:
8 5/8" 210' cem w/150 sx
5 1/2" 3635' cem w/75 sx

Elevation. 1739' RB

Production. 25 BOPD

Figures indicate Bottom of Formations.

| | |
|------------------------|------|
| sand | 20 |
| sand - red rock & lime | 175 |
| shale | 210 |
| red rock | 285 |
| shale & shells | 1100 |
| shale & red rock | 1250 |
| red rock & Anhydrite | 1440 |
| shale & lime | 1615 |
| lime & shale | 1785 |
| shale & lime | 2760 |
| lime | 2831 |
| shale & lime strks | 2845 |
| lime | 2989 |
| shale | 3093 |
| lime | 3385 |
| lime & shale strks | 3416 |
| shale & lime | 3527 |
| lime | 3601 |
| shale | 3604 |
| sand | 3638 |

Total Depth

TOPS:
Kansas City 3087
Viola 3547
Simpson Sand 3606

TOPS: SCOUT
Anhydrite 1250
Heebner 2913
Brown Lime 3056
Conglomerate 3422
Kinderhook 3453
Maquoketa 3470
Simpson Shale 3601

Core #1 3604-3626'

RECEIVED
STATE CORPORATION COMMISSION

SEP 27 1967

CONSERVATION DIVISION
Wichita, Kansas