


STATE OF KANSAS
STATE CORPORATION COMMISSION

WELL PLUGGING RECORD

Give All Information Completely
Make Required Affidavit
Mail or Deliver Report to:
Conservation Division
State Corporation Commission
212 No. Market
Wichita, Kansas

Reno County, Sec. 8 Twp. 22 Rge. (E) 9 (W)

Location as "NE/CNW/SW" or footage from lines SE SE NW
Lease Owner McAdams Pipe & Supply Company
Lease Name Brown Well No. 1
Office Address Drawer 960, Bristow, Oklahoma
Character of Well (completed as Oil, Gas or Dry Hole) oil
Date well completed _____ 19____
Application for plugging filed Sept. 26 1967
Application for plugging approved _____ 19____
Plugging commenced October 12 1967
Plugging completed October 17 1967
Reason for abandonment of well or producing formation depleted

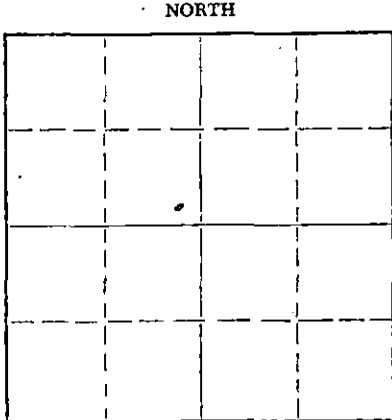

Locate well correctly on above Section Plat

If a producing well is abandoned, date of last production _____ 19____
Was permission obtained from the Conservation Division or its agents before plugging was commenced? yes

Name of Conservation Agent who supervised plugging of this well Gilbert Toman
Producing formation _____ Depth to top _____ Bottom _____ Total Depth of Well 3652 Feet
Show depth and thickness of all water, oil and gas formations.

OIL, GAS OR WATER RECORDS

CASING RECORD

FORMATION	CONTENT	FROM	TO	SIZE	PUT IN	PULLED OUT
		0	204'	8 5/8"	204'	none
		0	3651'	4 1/2"	3651'	3042.00

Describe in detail the manner in which the well was plugged, indicating where the mud fluid was placed and the method or methods used in introducing it into the hole. If cement or other plugs were used, state the character of same and depth placed, from _____ feet to _____ feet for each plug set.

Sand back to 3600', set 10' rock bridge and dumped 5 sacks of cement.

Set 10' rock bridge at 204' and dumped 5 sacks of cement. Let set overnight. Bailed hole down to 190' and dumped 20 sacks of cement. Filled hole with mud to 40', set 10' rock bridge and capped hole with 10 sacks of cement.

NOV 3 1967
CONSERVATION DIVISION
WICHITA, KANSAS

(If additional description is necessary, use BACK of this sheet)
Name of Plugging Contractor Pipe Pullers, Inc.
Address Box 486, Ellinwood, Kansas

STATE OF Kansas, COUNTY OF Barton, ss.
Dean Wells (employee of owner) or (owner or operator) of the above-described well, being first duly sworn on oath, says: That I have knowledge of the facts, statements, and matters herein contained and the log of the above-described well as filed and that the same are true and correct. So help me God.

(Signature) Dean Wells
Ellinwood, Kansas
(Address)

SUBSCRIBED AND SWORN TO before me this 30th day of October, 1967

My commission expires Feb. 10, 1971

George Meyer
Notary Public.


WELL LOG BUREAU—KANSAS GEOLOGICAL SOCIETY
50S East Murdock, Wichita, Kansas

Company- CHARLES S. RITCHIE
Farm- Brown No. 1

SEC. 8 T. 22 R. 9W
SE SE NW

Total Depth. 3652'
Comm. 3-1-59 Comp. 3-10-59
Shot or Treated.
Contractor. White & Ellis Drig.
Issued. 7-25-59

County Reno KANSAS

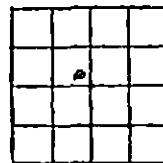

CASING:

8 5/8" 204' cem w/200 sx.
4 1/2" 3651' cem w/100 sx.

Elevation. 1735' RB

Production. 174 BOPD

Figures indicate Bottom of Formations.

Kelly Bushing Measures 5' above Ground Level.

sandy clay	40
sand & shale	180
red rock	400
red rock & shale	665
shale & shells	1240
lime & shale	1850
lime w/shale strks	2090
shale & shells	2335
shale & lime strks	2505
lime w/shale strks	2570
sandy shale	2612
lime	2903
lime & Sandy shale	3077
lime	3414
lime & shale	3526
lime	3597
shale	3602
sand & shale	3652
Total Depth	

Core #1 3600-3627'

TOPS:	
Heebner	2902
Brown Line	3048
Lansing-Kansas City	3077
Viola	3526
Simpson Shale	3597
Simpson Sand	3602

RECEIVED
STATE CORPORATION COMMISSION

SEP 27 1967

CONSERVATION DIVISION
Wichita, Kansas