


STATE OF KANSAS  
STATE CORPORATION COMMISSION  
Give All Information Completely  
Make Required Affidavit  
Mail or Deliver Report to:  
Conservation Division  
State Corporation Commission  
211 No. Broadway  
Wichita, Kansas

WELL PLUGGING RECORD

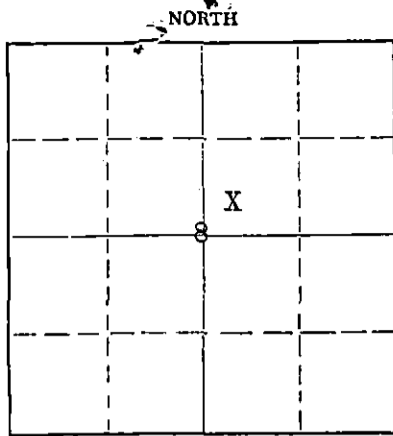

Locate well correctly on above Section Plat

Reno County. Sec. 8 Twp. 22 Rge. (E) 9 (W)  
Location as "NE/CNW/SW" or footage from lines. C W/2 SW NE  
Lease Owner Lario Oil & Gas Company  
Lease Name Ragland Well No. 1  
Office Address 301 S. Market, Wichita, Kansas 67202  
Character of Well (completed as Oil, Gas or Dry Hole) Oil  
Date well completed August 17 19 59  
Application for plugging filed October 3 19 63  
Application for plugging approved October 4 19 63  
Plugging commenced October 15 19 63  
Plugging completed October 21 19 63  
Reason for abandonment of well or producing formation Depleted

If a producing well is abandoned, date of last production November 19 59  
Was permission obtained from the Conservation Division or its agents before plugging was commenced? Yes

Name of Conservation Agent who supervised plugging of this well Gilbert Toman  
Producing formation Simpson Depth to top 3605 Bottom 3622 Total Depth of Well 3663 Feet  
Show depth and thickness of all water, oil and gas formations.

OIL, GAS OR WATER RECORDS

CASING RECORD

FORMATION	CONTENT	FROM	TO	SIZE	PUT IN	PULLED OUT
				8 5/8"	217'	None
				4 1/2"	3662'	3015'

Describe in detail the manner in which the well was plugged, indicating where the mud fluid was placed and the method or methods used in introducing it into the hole. If cement or other plugs were used, state the character of same and depth placed, from \_\_\_\_\_ feet to \_\_\_\_\_ feet for each plug set.

Cleaned out cellar, set plug at 3600' and run 3 sacks of cement. Worked 25" tension in 4 1/2" pipe, shot at 3112' and spotted oil. Shot at 3012' and started pipe. Set plug at 230' rock bridge 230' to 220', run 20 sacks of cement from 220' to 160' mudded from 160' to 40' rock and 10 sacks of cement from 40' to base of cellar.

RECEIVED  
STATE CORPORATION COMMISSION  
11-12-1963  
NOV 12 1963

CONSERVATION DIVISION  
Wichita, Kansas

(If additional description is necessary, use BACK of this sheet)  
Name of Plugging Contractor Glenn & Smith Pipe Pulling Co.  
Address Box 156, Ellinwood, Kansas

STATE OF Kansas, COUNTY OF Sedgwick, ss.  
Leo Ross (employee of owner) or (owner or operator) of the above-described well, being first duly sworn on oath, says: That I have knowledge of the facts, statements, and matters herein contained and the log of the above-described well as filed and that the same are true and correct. So help me God.

(Signature) *Leo Ross*  
301 S. Market, Wichita, Kansas 67202  
(Address)

SUBSCRIBED AND SWORN to before me this 8th day of November, 19 63

My commission expires June 28, 1964

*H. T. Cummins*  
Notary Public.

LARIO OIL & GAS COMPANY  
 Ragland No. 1  
 CW/2 SW NE Sec. 8-22S-9W  
 Reno County, Kansas

Drilling Commenced: July 15, 1959  
 Drilling Completed: July 24, 1959  
 Well Completed: August 17, 1959  
 Drilling Contractor- Group Exploration Company  
 Total Depth - 3663  
 I.P. - 18 bbls. oil plus 146 bbls. water 24 hours

Casing Record

8 5/8" 217 Cem. w/ 200 sacks  
 4 1/2" 3674 thds. off set @ 3662'  
 Cem. w/ 125 sacks

<u>Formation</u>	<u>Depth</u>	<u>Geological Tops - R.B. Meas.</u>	
Surface	170	Elevation	1737 R.B. 1735 D.F.
Red bed & shale	355	Brown lime	3044 -1307
Shale	1200	Lansing	3076 -1339
Lime	1840	Conglomerate	3408 -1671
Lime & shale	2040	Kinderhook	3411 -1674
Shale	2390	Maquoketa	3475 -1738
Shale & lime	2565	Viola	3533 -1796
Lime	2895	Simpson Shale	3602 -1865
Lime & shale	3040	Simpson Sand	3605 -1868
Lime	3445	Base of Simpson Sand	3622 -1885
Lime & shale	3530	Rotary T.D.	3663 -1926
Lime	3610	7-28-59	Welex perforated w/ 2 jets and 2 bullets per foot from 3608-3620'.
Sand	3624	7-29-59	Halliburton acidized with 500 gallons M.C.A. acid.
Shale	3630	7-30-59	Halliburton sandfraced with 10,000 gallons kerosene and 12,000# sand.
Simpson sand	3663		

RECEIVED  
 STATE CORPORATION COMMISSION

OCT 4 1959

CONSERVATION DIVISION  
 Wichita, Kansas