


WELL PLUGGING RECORD

Give All Information Completely
Make Required Affidavit
Mail or Deliver Report to:
Conservation Division
State Corporation Commission
800 Biting Building
Wichita, Kansas

Reno County, Sec. 17 Twp. 22 Rge. 9 (E) (W)
Location as "NE/CNW%SW%" or footage from lines SW SW SE
Lease Owner Manhart, Millison & Beebe
Lease Name 503 Jenkins Bldg. Tulsa, Okla Well No. 1
Office Address Proffett C #1
Character of Well (completed as Oil, Gas or Dry Hole) Dry Hole
Date well completed 9/9/55 19__
Application for plugging filed 9/8/55 19__
Application for plugging approved 9/8/55 19__
Plugging commenced 9/9/55 19__
Plugging completed 9/9/55 19__
Reason for abandonment of well or producing formation Dry Hole

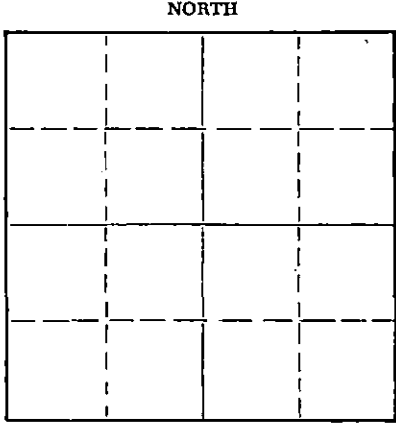

Locate well correctly on above Section Plat

If a producing well is abandoned, date of last production _____ 19__
Was permission obtained from the Conservation Division or its agents before plugging was commenced? yes

Name of Conservation Agent who supervised plugging of this well Ruel Durkee
Producing formation _____ Depth to top _____ Bottom _____ Total Depth of Well 3825 Feet
Show depth and thickness of all water, oil and gas formations.

OIL, GAS OR WATER RECORDS CASING RECORD

FORMATION	CONTENT	FROM	TO	SIZE	PUT IN	PULLED OUT
				8 5/8	204	none

Describe in detail the manner in which the well was plugged, indicating where the mud fluid was placed and the method or methods used in introducing it into the hole. If cement or other plugs were used, state the character of same and depth placed, from _____ feet to _____ feet for each plug set.

PLUGGING RECORD

Filled hole with heavy mud to 200'. Set 1st plug and bridged with brack. 15 sacks of cement. Filled hole with heavy mud to 20' and set 2nd plug & bridge. with 5 sacks cement.

9-15-55

RECEIVED
STATE CORPORATION COMMISSION
SEP 15 1955
CONSERVATION DIVISION
WICHITA, KANSAS

(If additional description is necessary, use BACK of this sheet)
Name of Plugging Contractor Trans Era Petroleum, Inc.
Address Russell, Kansas

STATE OF KANSAS COUNTY OF RUSSELL, ss.
Robert B. Snyder (employee of owner) or (owner or operator) of the above-described well, being first duly sworn on oath, says: That I have knowledge of the facts, statements, and matters herein contained and the log of the above-described well as filed and that the same are true and correct. So help me God.

(Signature) Robert B. Snyder
(Address) _____

SUBSCRIBED AND SWORN TO before me this 13th day of September, 1955

My commission expires 1-30-57 Margie Cooper Notary Public.

PLUGGING 90
REC REC 17 T 22 R 9
BOOK PAGE 149 LINE 16

Manhart, Millison & Beebe
Proffett C #1

SW SW SE 17-22-9
Reno County, Kansas

Trans Era Petroleum, Inc. - Contractor

Total Depth: 3825

Comm: 8/25/55
Comp: 9/9/55

Casing
8 5/8 set @ 204'

Cement
125 sacks of Bulk

FORMATION	DEPTH
Surface soil & clay	30
Sand & gravel	120
Redbed & shale	525
Shale & shells	945
Salt & shale	1035
Salt & shale	1350
Shale & lime	1800
Lime	1890
Lime & shale	2810
Lime	2845
Lime & shale	2918
Lime	2983
Lime & shale	3250
Lime	3292
Lime & shale	3318
Lime	3420
Lime & shale	3495
Conglomerate	3515
Kinderhook & shale	3550
Shale & lime	3690
Viola Lime	3742
Simpson	3808
Arbuckle	3825

STATE OF KANSAS)
) ss:
COUNTY OF RUSSELL)

I hereby certify that the above information is true and correct
to the best of my knowledge.

Robert B. Snubler

Subscribed and sworn to before me this 13th day of September, 1955.

Margie Cooper
Notary Public

My commission expires: 1-30-57

RECEIVED
STATE COMMISSION
SEP 15 1955
CONSERVATION DIVISION
Wichita, Kansas

PLUGGING
FILE SEC 17 T 22 R 9W
BOOK PAGE 49 LINE 16