


STATE OF KANSAS
STATE CORPORATION COMMISSION

WELL PLUGGING RECORD

Give All Information Completely
Make Required Affidavit
Mail or Deliver Report to
Conservation Division
State Corporation Comm.
245 North Water
Wichita, KS 67202

Finney County. Sec. 8 Twp. 22S Rge. 28 NW
Location as "NE/CNW $\frac{1}{4}$ SW $\frac{1}{4}$ " or footage from lines

C SE NW
Lease Owner Mack Oil Co.
Lease Name K. M. Winters Well No. #1
Office Address 908 Union Center, Wichita, Ks. 67202
Character of Well (Completed as Oil, Gas or Dry Hole)

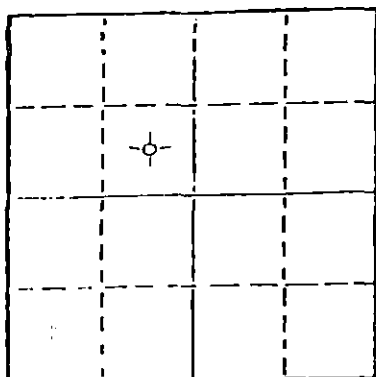

Locate well correctly on above
Section Plot

Dry Hole
Date Well completed 3-9-78 19
Application for plugging filed 3-8-78 19
Application for plugging approved 3-8-78 19
Plugging commenced 3-8-78 19
Plugging completed 3-9-78 19

Reason for abandonment of well or producing formation
Commercial quantities of oil not found
If a producing well is abandoned, date of last production 19

Was permission obtained from the Conservation Division or
its agents before plugging was commenced? Yes

Name of Conservation Agent who supervised plugging of this well Clarence Thomas, Jr.
Producing formation _____ Depth to top _____ Bottom _____ Total Depth of Well 4650'
Show depth and thickness of all water, oil and gas formations.

OIL, GAS OR WATER RECORDS

CASING RECORD

FORMATION	CONTENT	FROM	TO	SIZE	PUT IN	PULLED OUT
				8 5/8"	366'	None

Describe in detail the manner in which the well was plugged, indicating where the mud fluid was placed and the method or methods used in introducing it into the hold. If cement or other plugs were used, state the character of same and depth placed, from _____ feet to _____ feet for each plug set.

Plug @ 600' w/70 sx.
Plug @ 300' w/20 sx.
Plug @ 40' w/10 sx.

RECEIVED
STATE CORPORATION COMMISSION
MAR 17 1978
CONSERVATION DIVISION
WICHITA

3-17-78

(If additional description is necessary, use BACK of this sheet)

Name of Plugging Contractor Rains & Williamson Oil Co., Inc.

STATE OF Kansas COUNTY OF Sedgwick, ss.
Wilson Rains, President of Rains & Williamson Oil Co., Inc. (employee of owner) or (owner or operator) of the above-described well, being first duly sworn on oath, says: That I have knowledge of the facts, statements, and matters herein contained and the log of the above-described well as filed and that the same are true and correct. So help me God.

(Signature) Wilson Rains
435 Page Court, 220 W. Douglas, Wichita, Ks. 67202
(Address)



SUBSCRIBED AND SWORN TO before me this 11 day of March, 1978
My commission expires 10-4-79
Juanita M. Green Notary Public.

DRILLER'S LOG

COMPANY: Mack Oil Co.

SEC. 8 T. 22S R. 28W

WELL NAME: K. M. Winters #1

LOC. C SE NW

RIG NO. #7

COUNTY: Finney

TOTAL DEPTH 4650'

ELEVATION

COMMENCED: 2-25-78

COMPLETED: 3-9-78

CONTRACTOR: Rains & Williamson Oil Co., Inc.

CASING RECORD:

SURFACE: 8 5/8" @ 366' w/225 sx. common, 2% gel, 3% cc.

PRODUCTION: D&A

LOG

(Figures Indicate Bottom of Formations)

Shale	354
Shale & Sand	1175
Shale	1315
Sand	1510
Shale	2401
Shale & Lime	2950
Shale	3203
Lime	3377
Shale	3479
Lime & Shale	3622
Lime	3985
Lime & Shale	4132
Lime	4650
<u>ROTARY TOTAL DEPTH</u>	<u>4650</u>

RECEIVED
STATE CORPORATION COMMISSION

MAR 17 1978

CONSERVATION DIVISION
Wichita, Kansas

STATE OF Kansas)

COUNTY OF Sedgwick)

SS:


I, Wilson Rains, President of Rains & Williamson Oil Co., Inc.

upon oath state that the above and foregoing is a true and correct copy of the log of the

K. M. Winters #1 well.

Wilson Rains

Wilson Rains

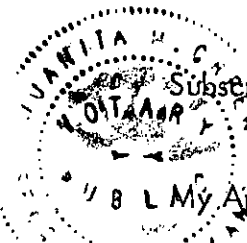

Subscribed and sworn to before me this 11 day of March, 1978.

My Appointment Expires:

10-4-79

Juanita M. Green

Juanita M. Green