

STATE OF KANSAS  
STATE CORPORATION COMMISSION


WELL PLUGGING RECORD

Give All Information Completely  
Make Required Affidavit  
Mail or Deliver Report to  
Conservation Division  
State Corporation Comm.  
245 North Water  
Wichita, KS 67202

Pawnee County. Sec. 19 Twp. 22S Rge. 17 EW  
Location as "NE/CNW $\frac{1}{2}$ SW $\frac{1}{2}$ " or footage from lines  
NW NE NW

Lease Owner Rains & Williamson Oil Co., Inc.  
Lease Name Eikmeier Well No. #1

Office Address 435 Page Court, 220 W. Douglas, Wichita, Ks.  
Character of Well (Completed as Oil, Gas or Dry Hole) Dry Hole

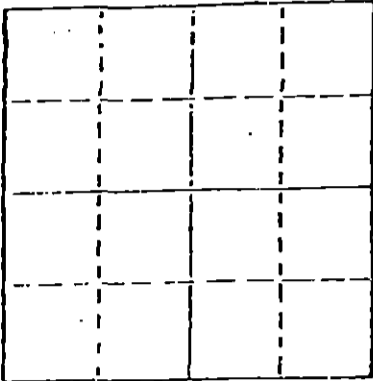

Locate well correctly on above  
Section Plat

Date Well completed 1-15-83 19  
Application for plugging filed 1-15-83 19  
Application for plugging approved 1-15-83 19  
Plugging commenced 1-15-83 19  
Plugging completed 1-15-83 19

Reason for abandonment of well or producing formation  
Commercial quantities of oil not found

If a producing well is abandoned, date of last production  
19.

Was permission obtained from the Conservation Division or  
its agents before plugging was commenced? Yes

Name of Conservation Agent who supervised plugging of this well Steve Durrant  
Producing formation \_\_\_\_\_ Depth to top \_\_\_\_\_ Bottom \_\_\_\_\_ Total Depth of Well 4250'

Show depth and thickness of all water, oil and gas formations.

OIL, GAS OR WATER RECORDS

CASING RECORD

FORMATION	CONTENT	FROM	TO	SIZE	PUT IN	PULLED OUT
				8 5/8"	361'	None

Describe in detail the manner in which the well was plugged; indicating where the mud fluid was placed and the method or methods used in introducing it into the hold. If cement or other plugs were used, state the character of same and depth placed, from \_\_\_\_\_ feet to \_\_\_\_\_ feet for each plug set.

Plug @ 1140' w/70 sx.  
Plug @ 390' w/40 sx.  
Plug @ 40' w/10 sx.  
Rat Hole 10 sx.

(If additional description is necessary, use BACK of this sheet)

Name of Plugging Contractor Rains & Williamson Oil Co., Inc.

STATE OF Kansas COUNTY OF Sedgwick, ss.  
Wilson Rains, President of Rains & Williamson Oil Co. (employee of owner) or (owner or operator) of the above-described well, being first duly sworn on oath, says: That I have knowledge of the facts, statements, and matters herein contained and the log of the above-described well as filed and that the same are true and correct. So help me God.

(Signature) Wilson Rains  
435 Page Court, 220 W. Douglas, Wichita, Ks. 67202  
(Address)

SUBSCRIBED AND SWORN TO before me this 24 day of January, 19 83

My commission expires 10-4-83

Juanita M. Green  
Juanita M. Green Notary Public.



DRILLER'S LOG

COMPANY: Rains & Williamson Oil Co., Inc.

SEC. 19 T. 22S R. 17W

LOC. NW NE NW

WELL NAME: -Eikmeier #1

COUNTY: Pawnee

RIG NO. #4

TOTAL DEPTH 4250'

ELEVATION 2081 GL 2086 KB

COMMENCED: 1-7-83

COMPLETED: 1-15-83

CONTRACTOR: Rains & Williamson Oil Co., Inc.

CASING RECORD:

SURFACE: 8 5/8" @ 361' w/225 sx. 60/40 poz., 2% gel, 3% cc.

PRODUCTION: D&A

LOG

(Figures Indicate Bottom of Formations)

Clay & Sand	50
Shale	2175
Lime & Shale	3575
Lime	4250
<u>ROTARY TOTAL DEPTH</u>	<u>4250</u>

RECEIVED  
STATE COMMISSION

JAN 31 1983

CONSERVATION DIVISION  
Wichita, Kansas

STATE OF Kansas)

COUNTY OF Sedgwick)

SS:

I, Wilson Rains, President of Rains & Williamson Oil Co., Inc.  
upon oath state that the above and foregoing is a true and correct copy of the log of the  
Eikmeier #1 well.

Wilson Rains  
Wilson Rains



Subscribed and sworn to before me this 24 day of January, 1983.

My Appointment Expires:  
10-4-83

Juanita M. Green  
Juanita M. Green