


Give All Information Completely  
Make Required Affidavit  
Mail or Deliver Report to:  
Conservation Division  
State Corporation Commission  
P. O. Box 17027  
Wichita, Kansas 67217  
NORTH

WELL PLUGGING RECORD

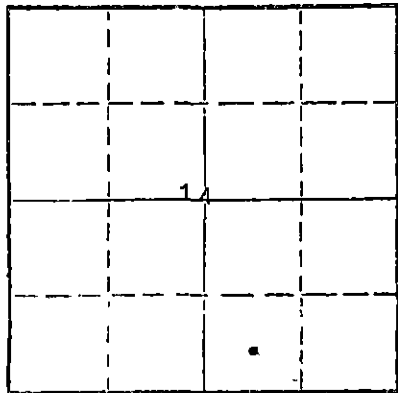

Locate well correctly on above Section Plat

HODGEMAN County, Sec. 14 Twp. 21s Rge. 25 (5)x (W)  
Location as "NE/CNWSW" or footage from lines App. C SW SE  
Lease Owner PETROLEUM, INC.  
Lease Name VIEUX 'D' Well No. 2  
Office Address R.R. #2, GREAT BEND, KANSAS  
Character of Well (completed as Oil, Gas or Dry Hole) DRY HOLE  
Date well completed MAY 15 19 73  
Application for plugging filed MAY 29 19 73  
Application for plugging approved MAY 30 19 73  
Plugging commenced AUG. 9 19 73  
Plugging completed AUG. 20 19 73  
Reason for abandonment of well or producing formation NO COMMERCIAL ZONE

If a producing well is abandoned, date of last production NONE 19  
Was permission obtained from the Conservation Division or its agents before plugging was commenced? YES

Name of Conservation Agent who supervised plugging of this well EDGAR J. EVES  
Producing formation \_\_\_\_\_ Depth to top \_\_\_\_\_ Bottom \_\_\_\_\_ Total Depth of Well 4503 Feet  
Show depth and thickness of all water, oil and gas formations.

OIL, GAS OR WATER RECORDS

CASING RECORD

FORMATION	CONTENT	FROM	TO	SIZE	PUT IN	PULLED OUT
MISSISSIPPI	SMALL AMOUNT			8-5/8"	404'	NONE
	OF WATER & OIL	4480	4486	5-1/2"	4502'	3504'

Describe in detail the manner in which the well was plugged, indicating where the mud fluid was placed and the method or methods used in introducing it into the hole. If cement or other plugs were used, state the character of same and depth placed, from \_\_\_\_\_ feet to \_\_\_\_\_ feet for each plug set.

PLUGGED BACK TO 4495' WITH CAST IRON BRIDGE PLUG. FILLED WITH SAND FROM 4495' TO 4470' FOLLOWED WITH 5 SACKS CEMENT FROM 4470' TO 4440'. PUMPED 50 SACKS CEMENT, 5 SACKS GEL MUD AND 15 SACKS CEMENT TO BASE OF WELL CELLAR.


RECEIVED  
STATE CORPORATION COMMISSION  
AUG 28 1973  
CONSERVATION DIVISION  
Wichita, Kansas

(If additional description is necessary, use BACK of this sheet)  
Name of Plugging Contractor GLENN PIPE PULLING COMPANY  
Address Box 156, ELLINWOOD, KANSAS

STATE OF KANSAS, COUNTY OF BARTON, ss.  
LAWRENCE PROFFITT (employee of owner) or (owner) of the above-described well, being first duly sworn on oath, says: That I have knowledge of the facts, statements, and matters herein contained and the log of the above-described well as filed and that the same are true and correct. So help me God. LAWRENCE PROFFITT, DIST. PROD. FOREMAN

(Signature) \_\_\_\_\_  
R.R. #2, GREAT BEND, KANSAS  
(Address)

Subscribed and sworn to before me this 27 day of AUGUST, 19 73  
Richard H. Dumlaker  
Notary Public.

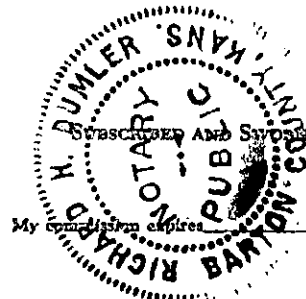

15.083.20296.00.00

DRILLERS LOG

#2 Vieux "D"

CASING RECORD:  
399.10' of new 8-5/8"  
surface casing.

COMPANY: Petroleum, Inc.  
CONTRACTOR: Strata Drilling, Inc.

DESCRIPTION: C/SW SE  
Section 14-21S-25W  
Hodgeman County, Kansas

TOTAL DEPTH:  
4503'

COMMENCED: April 5, 1973  
COMPLETED: April 16, 1973

<u>FORMATION</u>	<u>FROM</u>	<u>TO</u>	<u>REMARKS</u>
Clay, Shale & Sand	0	423	Ran 399.10' of new 8-5/8" surface casing; set and cemented at 404.60' with 225 sacks of common cement, 2% gel and 3% C. C. Plug down at 1:45 A. M. April 6, 1973.
Shale	423	1082	
Dakota Sand	1082	1279	
Shale	1279	1551	
Shale w/Sand Streaks	1551	1878	
Shale & Lime	1878	4224	
Lime	4224	4282	
Lime & Shale	4282	4400	
Lime	4400	4450	
Lime & Shale	4450	4503	

ROTARY TOTAL DEPTH: 4503'

Ran electric log.

5 1/2" O. D. casing set and cemented at 4502' with 75 sacks of pozmix, 10% salt. Plug down at 2:00 P. M. April 16, 1973.

RECEIVED  
STATE CORPORATION COMMISSION  
Aug 2 9 1973  
CONSERVATION DIVISION  
Wichita, Kansas

STATE OF KANSAS )  
                          ) ss.  
COUNTY OF BARTON)

I certify that this is a true and correct copy of the above log to the best of my knowledge.

STRATA DRILLING, INC.

*Charles W. Steincamp*  
Charles W. Steincamp, President

Subscribed and sworn to before me this 17th day of April, 1973.

My Commission Expires:



*Elaine H. Taylor*  
Elaine H. Taylor, Notary Public