


STATE OF KANSAS
STATE CORPORATION COMMISSION

Give All Information Completely
Make Required Affidavit
Mail or Deliver Report to:
Conservation Division
State Corporation Commission
211 No. Broadway
Wichita, Kansas

15.083.10227.00.00 Form CP-4
WELL PLUGGING RECORD

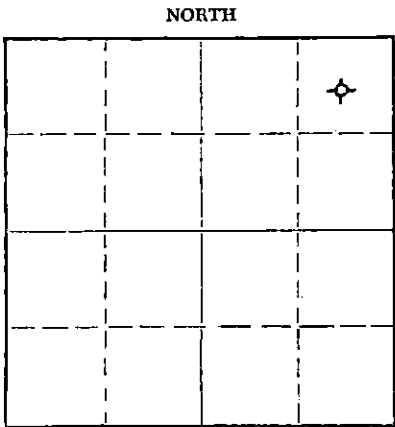

Locate well correctly on above Section Plat

Hodgeman County. Sec. 9 Twp. 21S Rge. (X) 25 (W)
Location as "NE/CNW/SW" or footage from lines C NE NE
Lease Owner Rains & Williamson Oil Co.
Lease Name GRASS Well No. 1
Office Address 412 Union Center - Wichita, Kansas
Character of Well (completed as Oil, Gas or Dry Hole) Dry Hole
Date well completed 5-13 1963
Application for plugging filed 5-13 1963
Application for plugging approved 5-13 1963
Plugging commenced 5-13 1963
Plugging completed 5-13 1963
Reason for abandonment of well or producing formation No oil or gas found in commercial quantities.
If a producing well is abandoned, date of last production ----- 19--
Was permission obtained from the Conservation Division or its agents before plugging was commenced? Yes

Name of Conservation Agent who supervised plugging of this well Mr. Eldon Petty, Hays, Kansas
Producing formation ----- Depth to top --- Bottom --- Total Depth of Well 4487 Feet
Show depth and thickness of all water, oil and gas formations.

OIL, GAS OR WATER RECORDS				CASING RECORD		
FORMATION	CONTENT	FROM	TO	SIZE	PUT IN	PULLED OUT
				8-5/8"	254.82'	NONE

Describe in detail the manner in which the well was plugged, indicating where the mud fluid was placed and the method or methods used in introducing it into the hole. If cement or other plugs were used, state the character of same and depth placed, from _____ feet to _____ feet for each plug set.

Set first plug at 540'. Cemented through drill pipe with 20 sacks cement. Filled hole with rotary mud to 240'. Set second plug at 240'. Cemented through drill pipe with 20 sacks of cement. Filled hole with rotary mud to 40' of base of cellar. Capped with 10 sacks of cement.

RECEIVED
STATE CORPORATION COMMISSION
MAY 16 1963
CONSERVATION DIVISION
Wichita, Kansas

(If additional description is necessary, use BACK of this sheet)
Name of Plugging Contractor Rains & Williamson Oil Co.
Address 412 Union Center - Wichita, Kansas

STATE OF KANSAS, COUNTY OF SEDGWICK, ss.
Wilson Rains - Partner (~~employee or owner~~) or (owner or operator) of the above-described well, being first duly sworn on oath, says: That I have knowledge of the facts, statements, and matters herein contained and the log of the above-described well as filed and that the same are true and correct. So help me God.
(Signature) Wilson Rains Wilson Rains
412 Union Center - Wichita, Kansas
(Address)

SUBSCRIBED AND SWORN TO before me this 14th day of May, 1963
Sherry Gish
Sherry Gish Notary Public.

My commission expires November 8, 1966

INVOICED
DATE 5/16/63
INV. NO. 7083-W

15.083-10227.00.00

ROTARY DRILLING LOG

OPERATOR: Rains & Williamson Oil Co.
#1 GRASS
C NE NE Section 9-21S-25W
Hodgeman County, Kansas

CONTRACTOR: Rains & Williamson
Oil Co.
COMMENCED: 5-2-63
COMPLETED: 5-13-63

Remarks: Set 8-5/8" surface casing at 254.82', cemented with 140 sacks quick cement

Formations

Shale	75'
Sand and Shale	110'
Shale and Shells	575'
Shale	720'
Shale and Sand	820'
Red Bed	965'
Anhydrite	980'
Shale	1075'
Sand and Shale	1300'
Shale and Red Beds	1575'
Anhydrite	1615'
Shale and Shells	2075'
Shale	2270'
Shale and Lime	2345'
Lime and Shale	2640'
Lime	2740'
Lime and Shale	3030'
Shale and Lime	3800'
Lime	3814'
Lime and Shale	3890'
Lime	4345'
Lime and Shale	4375'
Lime	4437'
Lime and Shale	4460'
Lime	4487'
Rotary Total Depth (D&A)	4487'

RECEIVED
STATE CORPORATION COMMISSION

MAY 16 1963

CONSERVATION DIVISION
Wichita, Kansas

We certify the above log is true and correct to the best of our knowledge and belief.

RAINS & WILLIAMSON OIL CO.

Wilson Rains
Wilson Rains
Partner

Subscribed and sworn to before me, a Notary Public in and for the State of Kansas, County of Sedgwick, this 14th day of May, 1963.

Sherry Gish
Sherry Gish-Notary Public

My Commission Expires: Nov. 8, 1966