


STATE OF KANSAS  
STATE CORPORATION COMMISSION

Form CP-4

Give All Information Completely  
Make Required Affidavit  
Mail or Deliver Report to:  
Conservation Division  
State Corporation Commission  
P. O. Box 17027  
Wichita, Kansas 67217  
NORTH

15.083.20372.00.00  
WELL PLUGGING RECORD

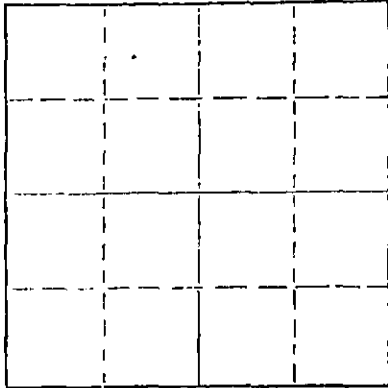

Locate well correctly on above  
Section Plat

Hodgeman County. Sec. 34 Twp. 21 Rge. 24 (E) (W) X  
Location as "NE/CNW&SW" or footage from lines C/NW/SE  
Lease Owner Oasis Petroleum, Inc. c/o Continental Oil Co.  
Lease Name EVERTON Well No. 4  
Office Address P. O. Box 267, Great Bend, Kansas 67530  
Character of Well (completed as Oil, Gas or Dry Hole) \_\_\_\_\_  
Date well completed \_\_\_\_\_ 19\_\_\_\_  
Application for plugging filed \_\_\_\_\_ 19\_\_\_\_  
Application for plugging approved \_\_\_\_\_ 19\_\_\_\_  
Plugging commenced August 5, 19 74  
Plugging completed August 7, 19 74  
Reason for abandonment of well or producing formation Depleted

If a producing well is abandoned, date of last production \_\_\_\_\_ 19\_\_\_\_  
Was permission obtained from the Conservation Division or its agents before plugging was commenced? Yes

Name of Conservation Agent who supervised plugging of this well Edgar Eves  
Producing formation \_\_\_\_\_ Depth to top \_\_\_\_\_ Bottom \_\_\_\_\_ Total Depth of Well 4715 Feet  
Show depth and thickness of all water, oil and gas formations.

OIL, GAS OR WATER RECORDS

CASING RECORD

FORMATION	CONTENT	FROM	TO	SIZE	PUT IN	PULLED OUT
				8 5/8	675	None
				5 1/2	4710	3787.90

Describe in detail the manner in which the well was plugged, indicating where the mud fluid was placed and the method or methods used in introducing it into the hole. If cement or other plugs were used, state the character of same and depth placed, from \_\_\_\_\_ feet to \_\_\_\_\_ feet for each plug set.

4622' cast iron plug and 2 sacks cement.


Shot casing at 3930 and 3830'. Pulled a total of 124 joints of 5 1/2" casing. Squeezed well with 1 sack hulls, 10 sacks gel, 1 sack hulls, 50 sacks 50/50 Pozmix cement, 5 sacks gel and 1 sack hulls, capped well with 50 sacks 50/50 Pozmix cement.

RECEIVED  
STATE CORPORATION COMMISSION  
AUG 9 1974  
CONSERVATION DIVISION  
Wichita, Kansas

Name of Plugging Contractor Rockhold Engineering, Inc.  
Address p. O. Box 698, Great Bend, Kansas 67530  
(If additional description is necessary, use BACK of this sheet)

STATE OF Kansas COUNTY OF Barton ss.  
James W. Rockhold

(employee of owner) or (owner or operator) of the above-described well, being first duly sworn on oath, says: That I have knowledge of the facts, statements, and matters herein contained and the log of the above-described well as filed and that the same are true and correct. So help me God.

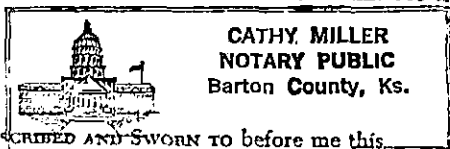

(Signature) James W. Rockhold  
Box 698, Gt. Bend, Ks. 67530 James W. Rockhold  
(Address)

Subscribed and Sworn to before me this 8th day of August, 1974

Cathy Miller  
Notary Public.

Commission expires September 30, 1975

DRILLERS LOG

COMPANY: CONTINENTAL OIL COMPANY  
 3535 Northwest 58th Street  
 Oklahoma City, Oklahoma

LEASE NAME: EVERTON No. 4  
 C NW SE 34-21-24W  
 Hodgeman County, Kansas

CONTRACTOR: SLAWSON DRILLING COMPANY, INC.  
 408 One Twenty Building  
 Wichita, Kansas 67202

TOTAL DEPTH 4715'

COMMENCED 5/24/74

COMPLETED 6/2/74

casing 682' 8-5/8" with 375 sax cement

Oil String 5 1/2" run to 4712' 6/2/74

0 to 325'	Shale
325' to 686'	12 1/2" Surface Hole, Shale & Shells
686 to 1704'	Shale & shells
1704 to 1745'	Anhydrite
1745 to 2527'	Shale
2527 to 3655'	Lime-Shale
3655 to 3830'	Shale & Lime
3830 to 4080	Lime & Shale
4080 to 4548'	Lime
4548 to 4620'	Lime & Shale
4620 to 4693	Lime & Miss
4693 to 4715	Lime
4715	Miss
4715	RTD

RECEIVED  
 STATE CORPORATION COMMISSION  
 JUN 14 1974  
 CONSERVATION DIVISION  
 Wichita, Kansas

STATE OF KANSAS  
 COUNTY OF SEDGWICK

I, James C. Remsberg, of the Slawson Drilling Company, Inc.  
 upon oath state that the above and foregoing is a true and correct copy of the  
 log of the Everton No. 4 well.

*James C. Remsberg*  
 James C. Remsberg

Subscribed and sworn to me on June 5, 1974

*Mary Lou Taylor*  
 Mary Lou Taylor, Notary



My commission expires January 17, 1977