

15.083.10027.00.00

STATE OF KANSAS
STATE CORPORATION COMMISSION

Form CP-4

WELL PLUGGING RECORD

Give All Information Completely
Make Required Affidavit
Mail or Deliver Report to:
Conservation Division
State Corporation Commission
211 No. Broadway
Wichita, Kansas

Hodgeman County. Sec. 26 Twp. 22S Rge. (E) 23W(W)

Location as "NE/CNW&SW" or footage from lines. SE¹/₄ SE¹/₄

Lease Owner Birmingham-Bartlett Drilling Co.

Lease Name Jensen Well No. 1

Office Address 300 Kaufman Building, Wichita, Kansas, 67202

Character of Well (completed as Oil, Gas or Dry Hole) Oil Well

Date well completed December 1, 19 63

Application for plugging filed March 31, 19 65

Application for plugging approved April 1, 19 65


Plugging commenced April 8, 19 65

Plugging completed April 16, 19 65

Reason for abandonment of well or producing formation Production declined to a point where well no longer economical to operate.

If a producing well is abandoned, date of last production April 6, 19 65

Was permission obtained from the Conservation Division or its agents before plugging was commenced? Yes

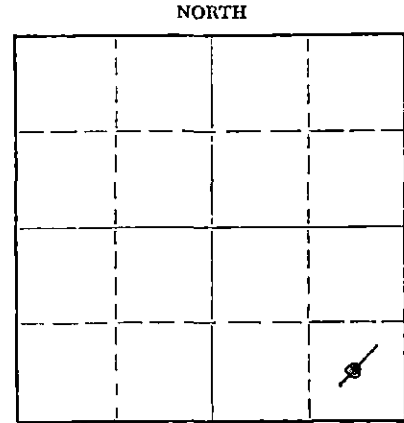

Locate well correctly on above Section Plat

Name of Conservation Agent who supervised plugging of this well Hugh Scott

Producing formation Mississippi Osage Depth to top 4491 Bottom Total Depth of Well 4509 Feet

Show depth and thickness of all water, oil and gas formations.

OIL, GAS OR WATER RECORDS

CASING RECORD

FORMATION	CONTENT	FROM	TO	SIZE	PUT IN	PULLED OUT
		0	240	8-5/8"	242'	None
		0	4504'	5-1/2"	APPROX. 4504'	3470'

Describe in detail the manner in which the well was plugged, indicating where the mud fluid was placed and the method or methods used in introducing it into the hole. If cement or other plugs were used, state the character of same and depth placed, from _____ feet to _____ feet for each plug set.

Plugged back with sand from 4509' to 4490'. Mixed and dumped 5 sx. of cement from 4490' to 4450' with dump bailer. Pulled casing to 700'. Circulated mud. Mixed and pumped in 25 sx. of cement from 700' to 625'. Pulled casing to 250'. Mixed and pumped in 25 sx. of cement from 250' to 175'. Pulled rest of the casing. Bailed off fluid to 50'. Set 5' rock bridge from 50' to 450'. Mixed and dumped 15 sx. of cement from 45' to base of the cellar.

RECEIVED
STATE CORPORATION COMMISSION

APR 27 1965 4-27-65

CONSERVATION DIVISION
Wichita, Kansas

(If additional description is necessary, use BACK of this sheet)

Name of Plugging Contractor Ace Pipe Pulling Co.

Address Box 304 Great Bend, Ks.

STATE OF KANSAS, COUNTY OF SEDGWICK
Chas. H. Keevert, Prod. Supt. of Birmingham-Bartlett Drilling Co., ss.

(employee of owner) or (owner or operator) of the above-described well, being first duly sworn on oath, says: That I have knowledge of the facts, statements, and matters herein contained and the log of the above-described well as filed and that the same are true and correct. So help me God.

(Signature) Chas. H. Keevert

Wilson Road, Route 1, Hutchinson, Kansas
(Address)

SUBSCRIBED AND SWORN TO before me this 26th day of April, 19 65

My commission expires November 29, 1966.

Vivian F. Yinger
Notary Public.

JENSEN NO. 1 WELL

LOCATION: 150 feet south of
Center SE $\frac{1}{4}$ SE $\frac{1}{4}$
Sec. 26-22S-23W
Hodgeman County, Kansas

SPUDDED: 10-30-63

COMPLETED: 11-17-63

OWNER, OPERATOR
and CONTRACTOR: Birmingham-Bartlett Drilling Co.
300 Kaufman Building
Wichita, Kansas; 67202

SURFACE CASING: 8-5/8" cemented at 240 feet
with 185 sacks cement.

OIL STRING: 5-1/2" OD 14# 8 rd. J-55 R-2
5mils. casing cemented at 4504'
with 100 sacks cement.

L O G

(Figures Indicate bottom of formation)

0 -	100	Clay sand
	210	Shale
	310	Shale and shells
	800	Shale
	814	Blaine Anhydrite
	900	Shale
	1100	Sand
	1165	Shale
	1427	Shale and Red Bed
	1457	S. C. Anhydrite
	2230	Shale and Shells
	2590	Lime and Shale
	2700	Lime
	3736	Lime and Shale
	3799	Lime
	3830	Lime and Shale
	4347	Lime
	4394	Lime and Shale
	4410	Fort Scott
	4457	Lime
	4475	Lime and Shale
	4497	Miss. Warsaw
	4509	Lime
	4509	Rotary total depth

RECEIVED
STATE CORPORATION COMMISSION

APR 1 1965

CONSERVATION DIVISION
Wichita, Kansas

The undersigned, Richard Hindery, one of the partners of Birmingham-Bartlett Drilling Co., hereby certifies that the above is a true and correct log of the JENSEN NO. 1 WELL as shown in the daily drilling reports.

BIRMINGHAM-BARTLETT DRILLING CO.

By Richard Hindery
Richard Hindery, Partner

Subscribed and sworn to before
me this 18th day of November, 1963.

Vivian F. Yinger
Vivian F. Yinger, Notary Public

My commission expires November 29, 1966.