

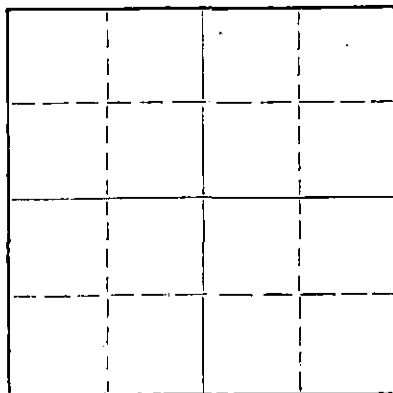
Give All Information Completely  
Make Required Affidavit  
Mail or Deliver Report to:  
Conservation Division  
State Corporation Commission  
211 No. Broadway  
Wichita, Kansas

WELL PLUGGING RECORD

Hodgeman County, Sec. 25 Twp. 22S Rge. 23W (E) (W)

Location as "NE/CNW/SW" or footage from lines G SW SW  
 Lease Owner Imperial Oil Company  
 Lease Name BILLINGS Well No. 3  
 Office Address 780 Fourth National Bldg., Wichita, Ks.  
 Character of Well (completed as Oil, Gas or Dry Hole) dry hole  
 Date well completed 7-20-63 19  
 Application for plugging filed 7-20-63 19  
 Application for plugging approved 7-20-63 19  
 Plugging commenced 7-20-63 19  
 Plugging completed 7-20-63 19  
 Reason for abandonment of well or producing formation No commercial quantities of oil found.  
 If a producing well is abandoned, date of last production: -- 19  
 Was permission obtained from the Conservation Division or its agents before plugging was commenced? Yes

NORTH



Locate well correctly on above Section Plat

Name of Conservation Agent who supervised plugging of this well Hugh Scott  
 Producing formation -- Depth to top -- Bottom -- Total Depth of Well 4582 Feet  
 Show depth and thickness of all water, oil and gas formations.

OIL, GAS OR WATER RECORDS

CASING RECORD

FORMATION	CONTENT	FROM	TO	SIZE	PUT IN	PULLED OUT
	Surface casing	-		8-5/8"	1447'	Not pulled

Describe in detail the manner in which the well was plugged, indicating where the mud fluid was placed and the method or methods used in introducing it into the hole. If cement or other plugs were used, state the character of same and depth placed, from \_\_\_\_\_ feet to \_\_\_\_\_ feet for each plug set.

Set first plug at 500' with 20 sacks cement.  
 Set second plug at 300' with 15 sacks.  
 Set third plug at 40' with 10 sacks.

RECEIVED  
STATE CORPORATION COMMISSION

JUL 25 1963

CONSERVATION DIVISION  
Wichita, Kansas

(If additional description is necessary, use BACK of this sheet)  
 Name of Plugging Contractor Imperial Oil of Kansas, Inc.  
 Address Box 97, Wakeeney, Kansas

STATE OF KANSAS COUNTY OF SEDGWICK  
R. L. Bacon (employee of owner) or (owner or operator) of the above-described well, being first duly sworn on oath, says: That I have knowledge of the facts, statements, and matters herein contained and the log of the above-described well as filed and that the same are true and correct. So help me God.

(Signature) R. L. Bacon  
780 Fourth National Bldg., Wichita, Ks. (Address)

SUBSCRIBED AND SWORN TO before me this 24th day of July, 19 63

My commission expires May 25, 1966.  
Margaret C. Phillips  
 Margaret C. Phillips Notary Public.

15.083.10090.00.00

DRILLER'S LOG

Imperial Oil Company  
Fourth National Bldg.  
Wichita, Kansas

BILLINGS NO. 3  
C SW SW, Sec.25-22S-23W  
Hodgeman County, Kansas

Total Depth: 4582 ft.

Elevation: 2291 KB

Commenced: July 7, 1963

Completed: July 20, 1963

Contractor: Imperial Oil of Kansas, Inc.  
Wichita 2, Kansas

Production: Dry

Casing Record: Set 8-5/8" surface pipe at 1447' with 600 sacks cement.

Figures indicate bottom of formations:

TOPS:

Post Rock	40'
Sand & Shale	550'
Shale & Shells	825'
Anhydrite	833'
Shale & Shells	915'
Dakota Sand	1115'
Red Bed	1442'
Anhydrite	1480'
Red Bed & Shale	1705'
Shale & Shells	2325'
Lime & Shale	4110'
Lime	4180'
Lime & Shale	4484'
Lime	4520'
Lime & Shale	4541'
Lime	4582'

Anhydrite	1442 (- 849)
Heebner	3882 (-1541)
Toronto	3850 (-1559)
Douglas Lime	3891 (-1600)
Lansing	3912 (-1621)
Base Kansas City	4233 (-1942)
Cherokee Shale	4435 (-2144)
Conglomerate	
Shale	4510 (-2219)
Warsaw Dolomite	4546 (-2255)
Osage	4574 (-2283)
RTD	4582 (-2291)

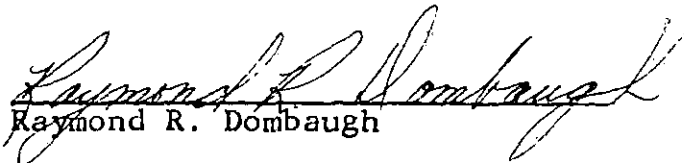
**RECEIVED**  
STATE CORPORATION COMMISSION

JUL 25 1963

CONSERVATION DIVISION  
Wichita, Kansas

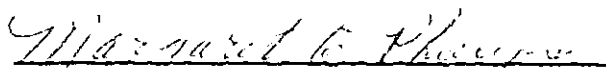
We hereby certify this to be a correct and accurate log of the above described well as shown on the daily drilling reports.

IMPERIAL OIL COMPANY

  
Raymond R. Dombaugh

Subscribed and sworn to before me this 24th day of July, 1963.

My commission expires: 7/1/1966

  
Margaret C. Phillips,  
Notary Public