

15.083.20138.00.01

STATE OF KANSAS
STATE CORPORATION COMMISSION

Form CP-4


Give All Information Completely
Make Required Affidavit
Mail or Deliver Report to:
Conservation Division
State Corporation Commission

P. O. Box 17027
Wichita, Kansas 67217
NORTH

WELL PLUGGING RECORD

Hodgman County, Sec. 9 Twp. 22 Rge. 23 (E) (W)

Location as "NE/CNW/SW" or footage from lines SW NW
Lease Owner Thunderbird Drilling, Inc.
Lease Name Campbell #1 Well No.
Office Address Ellinwood, Kansas 67526
Character of Well (completed as Oil, Gas or Dry Hole)
Date well completed 10
Application for plugging filed 10
Application for plugging approved 10
Plugging commenced 12/4/74 10
Plugging completed 12/10/74 10
Reason for abandonment of well or producing formation depleted.

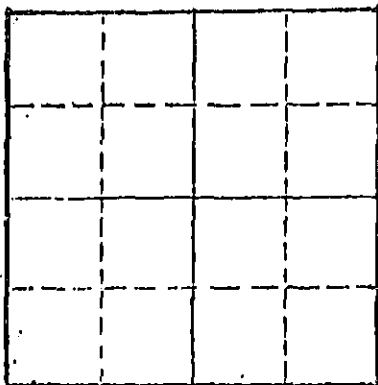

Locate well correctly on above
Section Plot

If a producing well is abandoned, date of last production 10
Was permission obtained from the Conservation Division or its agents before plugging was com-
menced? yes

Name of Conservation Agent who supervised plugging of this well Thomas
Producing formation Depth to top Bottom Total Depth of Well 4644 Feet
Show depth and thickness of all water, oil and gas formations.

OIL, GAS OR WATER RECORDS

CASING RECORD

FORMATION	CONTENT	FROM	TO	SIZE	PUT IN	PULLED OUT
				8-5/8		none
				5 1/2"	4636	2638'

Describe in detail the manner in which the well was plugged, indicating where the mud fluid was placed and the method or methods used
in introducing it into the hole. If cement or other plugs were used, state the character of same and depth placed, from feet to
feet for each plug set.

Checked hole to 4644', ran sand to 4600' and ran 5 sacks cement.
Shot pipe at 2989', 3777', 3482', 3271', 3020', 2806', 2709', 2586',
pulled 55 joints. Pumped mud, had hole in casing, pulled 27 joints.
Pumped 3 sacks hulls, 10 sacks gel, 1 sack hulls and 50 sacks cement,
4 sacks gel, 1 sack hulls, 35 sacks cement, 5 sacks gel, 1 sack hulls
and 15 sacks cement.

PLUGGING COMPLETE.

RECEIVED
STATE CORPORATION COMMISSION
DEC 23 1974
CONSERVATION DIVISION
Wichita, Kansas

Name of Plugging Contractor KNIGHT CASING PULLING CO., INC.
Address CHASE, KANSAS


STATE OF KANSAS COUNTY OF RICE
NOEL J. KNIGHT ss.

well, being first duly sworn on oath, says: That I have knowledge of the facts, statements, and matters herein contained and the log of the
above-described well as filed and that the same are true and correct. So help me God.

(Signature) Noel Knight
CHASE, KANSAS
(Address)

Subscribed and Sworn to before me this 20th day of December, 1974

My commission expires

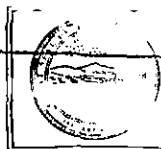

MARGARET J. ELMER
NOTARY PUBLIC
Rice County, Kansas
My Commission Expires
Feb. 15, 1975

Margaret J. Elmer
Notary Public.