


Give All Information Completely
Make Required Affidavit
Mail or Deliver Report to:
Conservation Division
State Corporation Commission
211 No. Broadway
Wichita, Kansas

WELL PLUGGING RECORD

NORTH

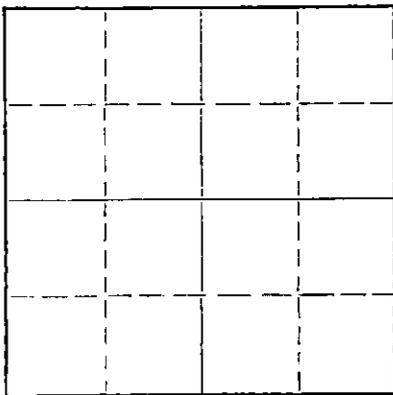

Locate well correctly on above
Section Plat

Hodgeman County. Sec. 9 Twp. 22S Rge. 23W (E) (W)
Location as "NE/CNW/SW" or footage from lines. NW SW
Lease Owner James W. Hershberger
Lease Name CAMPBELL Well No. 1
Office Address 1039 First National Bank Building, Wichita, Kansas
Character of Well (completed as Oil, Gas or Dry Hole) Dry Hole
Date well completed November 17, 1962 19
Application for plugging filed November 17, 1962 (Verbal) 19
Application for plugging approved November 17, 1962 (Verbal) 19
Plugging commenced November 17, 1962 19
Plugging completed November 17, 1962 19
Reason for abandonment of well or producing formation _____

If a producing well is abandoned, date of last production _____ 19
Was permission obtained from the Conservation Division or its agents before plugging was commenced? Yes

Name of Conservation Agent who supervised plugging of this well Mr. Eldon Petty, Hays, Kansas
Producing formation _____ Depth to top _____ Bottom _____ Total Depth of Well 4631 Feet
Show depth and thickness of all water, oil and gas formations.

OIL, GAS OR WATER RECORDS

CASING RECORD

FORMATION	CONTENT	FROM	TO	SIZE	PUT IN	PULLED OUT
				8-5/8"	297'	

Describe in detail the manner in which the well was plugged, indicating where the mud fluid was placed and the method or methods used in introducing it into the hole. If cement or other plugs were used, state the character of same and depth placed, from _____ feet to _____ feet for each plug set.

Set plug @550' w/20 Sx.
Set plug @300' w/20 Sx.
Set plug @35' w/ 10 Sx.
2 Sx. in rat hole.

NOV 30 1962
CONSERVATION DIVISION
Wichita, Kansas
11-30-1962

(If additional description is necessary, use BACK of this sheet)

Name of Plugging Contractor Raymond Oil Company, Inc.
Address 410 Fourth National Bank Building, Wichita 2, Kansas

STATE OF KANSAS, COUNTY OF SEDGWICK, ss.
Patrick R. Raymond (employee of owner) or (owner or operator) of the above-described well, being first duly sworn on oath, says: That I have knowledge of the facts, statements, and matters herein contained and the log of the above-described well as filed and that the same are true and correct. So help me God.

(Signature) Patrick R. Raymond
410 Fourth National Bank Building
(Address)

SUBSCRIBED AND SWORN TO before me this 28th day of November, 1962

Barbara A. Kennedy
Notary Public.

My commission expires July 9, 1966



15. 083. 10059. 00. 00

JAMES W. HERSHBERGER
No. 1 CAMPBELL
NW SW 9-22S-23W
Hodgeman County, Kansas

ELEVATION: 2366 KB.
2363 DF
2361 GL

Contractor: Raymond Oil Company, Inc. - Rig #3
Commenced: November 2, 1962
Completed: November 17, 1962

Casing Record:
8-5/8" @297' w/225 Sx.

Figures Indicate Bottom of Formation

<u>Formation</u>	<u>Depth</u>
Sand and Clay	45
Clay and Shells	300
Shale and Shells	786
Redbed and Shells	1085
Sand	1285
Shale and Shells	1450
Redbed	1619
Anhydrite	1670
Shale and Shells	2300
Shale and Lime	2450
Lime and Shale	3175
Shale, Lime and Chalk	3295
Shale and Lime	3560
Shale, Chalky Lime	3675
Shale and Lime	3790
Lime - Chalky	3895
Shale and Lime	4067
Lime	4157
Lime and Shale	4186
Lime	4330
Lime and Shale	4460
Lime	4607
Lime and Chert	4612
Lime	4625
Lime and Chert	4631 TD
<u>TOPS</u>	
Heebner	3934
Lansing	3985
Base Lansing	4356
Cherokee	4512
Mississippi	4602
Osage	4621
Rotary Total Depth	4631

RECEIVED
STATE CORPORATION COMMISSION
NOV 30 1962
CONSERVATION DIVISION
Wichita, Kansas

