

STATE OF KANSAS
STATE CORPORATION COMMISSION


Give All Information Completely
Make Required Affidavit
Mail or Deliver Report to:
Conservation Division
State Corporation Commission
211 No. Broadway
Wichita, Kansas

15.083.00024.00.00
WELL PLUGGING RECORD

Hodgeman County, Sec. 9 Twp. 22S Rge. (E) 23 (W)

Location as "NE/CNW&SW&S" or footage from lines C SW NE
Lease Owner Pickrell Drilling Company
Lease Name Kaufman Well No. 1
Office Address 705 Fourth National Bank Bldg., Wichita 2, Kansas
Character of Well (completed as Oil, Gas or Dry Hole) Dry Hole
Date well completed November 11, 19 61
Application for plugging filed November 11, 19 61
Application for plugging approved November 11, 19 61
Plugging commenced November 11, 19 61
Plugging completed November 11, 19 61
Reason for abandonment of well or producing formation Dry Hole

NORTH

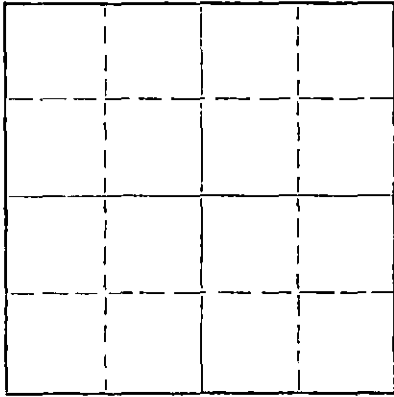

Locate well correctly on above
Section Plat

If a producing well is abandoned, date of last production 19____
Was permission obtained from the Conservation Division or its agents before plugging was commenced? Yes

Name of Conservation Agent who supervised plugging of this well Frank Broadfoot
Producing formation _____ Depth to top _____ Bottom _____ Total Depth of Well 4645 Feet
Show depth and thickness of all water, oil and gas formations.

OIL, GAS OR WATER RECORDS

CASING RECORD

FORMATION	CONTENT	FROM	TO	SIZE	PUT IN	PULLED OUT
				8 5/8"	290'	None

Describe in detail the manner in which the well was plugged, indicating where the mud fluid was placed and the method or methods used in introducing it into the hole. If cement or other plugs were used, state the character of same and depth placed, from _____ feet to _____ feet for each plug set.

Heavy mud to 280'. Set Plug. Cemented with 25 sacks cement. Heavy mud to 35'. Set Plug. Cemented with 10 sacks cement to bottom of cellar. Plugged rat hole with 2 sacks cement.

(If additional description is necessary, use BACK of this sheet)

Name of Plugging Contractor Pickrell Drilling Company
Address 705 Fourth National Bank Bldg., Wichita 2, Kansas

STATE OF KANSAS, COUNTY OF SEDGWICK, ss.
C. W. Sebitts (owner or operator)

well, being first duly sworn on oath, says: That I have knowledge of the facts, statements, and matters herein contained and the log of the above-described well as filed and that the same are true and correct. So help me God.

(Signature) C. W. Sebitts
705 Fourth National Bank Bldg., Wichita, Ks.
(Address)

SUBSCRIBED AND SWORN TO before me this 21st day of November 19 61

My commission expires September 24, 1962 Maxine Johnson Notary Public.



15.083.00024.00.00
ROTARY DRILLING LOG

COMPANY: Pickrell Drilling Company
705 Fourth National Bank Bldg.
Wichita 2, Kansas.

LOCATION: KAUFMAN #1 - C SW NE, Sec. 9-22S-23W,
Hodgeman County, Kansas

Rotary Drilling Commenced 10-27-61

Rotary Drilling Completed 11-11-61

CONTRACTOR: **PICKRELL DRILLING COMPANY**
Wichita, Kansas

CASING RECORD: 290' (8 jts.) 8 5/8" 20# Surface Casing with 170 sacks cement.
Circulated. No oil string run. D & A

LOG

(Figures indicate bottom of formation — measurements from top of rotary bushing.)

		<u>Circulated for Samples</u>
160'	Sand & Clay	4550'
370'	Blue Shale	4581'
400'	Sand	4608'
745'	Shale & Shells	4616'
980'	Shale, Shells & Red Bed	4626'
1012'	Blaine	4634'
1040'	Shale & Shells	4640'
1275'	Shale & Sand	4645'
1605'	Shale & Shells	
1640'	Anhydrite	
2070'	Shale & Shells	<u>Slope Test</u>
2455'	Shale & Lime	1640' 0°
2930'	Lime	2555' 0°
3465'	Lime & Shale	3465' 0°
3685'	Lime, Shale & Sand	4325' 0°
3790'	Lime & Shale	
3890'	Lime	<u>S. L. M.</u>
4035'	Lime & Shale	1600'
4071'	Lime	2800'
4134'	Lime & Shale	4100'
4480'	Lime	
4550'	Lime & Shale	
4616'	Lime	
4626'	Mississippi Chert	
4634'	Lime Chert	
4645'	Mississippi Chert R.T.D.	

The undersigned, C. W. Sebitts, Attorney-in-Fact for PICKRELL DRILLING COMPANY, hereby certifies in behalf of said Company, that the above is a true and correct log of the formation encountered in drilling the above well as reflected by the Daily Drilling Reports.

PICKRELL DRILLING COMPANY
By C. W. Sebitts Attorney-in-Fact

STATE OF KANSAS }
COUNTY OF SEDGWICK } ss.:

On this 21st day of November, 19 61, before me the undersigned, a Notary Public, in and for

the County and State aforesaid, personally appeared C. W. Sebitts, to me known to be the identical person who subscribed the name of PICKRELL DRILLING COMPANY to the foregoing instrument as its Attorney-in-Fact and acknowledged to me that he executed the same as his free and voluntary act and deed, and as the free and voluntary act and deed of such company, for the uses and purposes therein set forth.

Given under my hand and seal of office the day and year last above written.

My commission expires: September 24, 1962

Maxine Johnson
Maxine Johnson Notary Public