

15.083.10308.00.00

WELL PLUGGING RECORD

Give All Information Completely
Make Required Affidavit
Mail or Deliver Report to:
Conservation Division
State Corporation Commission
211 No. Broadway
Wichita, Kansas

Hodgeman

County. Sec. 17 Twp. 22 Rge. 22 (E) W (W)

Location as "NE/CNWxSWx" or footage from lines C SW SE

Lease Owner Schultz, Turner & Webb

Lease Name Ewy "A" Well No. 2

Office Address Dallas, Texas

Character of Well (completed as Oil, Gas or Dry Hole) Dry

Date well completed 2-21-63 19__

Application for plugging filed 9-20-63 19__

Application for plugging approved 9-23-63 19__

Plugging commenced 9-27-63 19__


Plugging completed 10-2-63 19__

Reason for abandonment of well or producing formation ABANDONED Failed to establish production during completion operations

If a producing well is abandoned, date of last production did not produce 19__

Was permission obtained from the Conservation Division or its agents before plugging was commenced? yes

NORTH

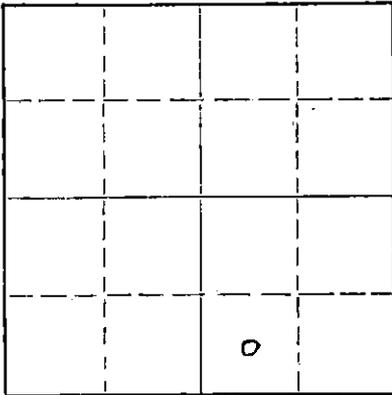

Locate well correctly on above Section Plat

Name of Conservation Agent who supervised plugging of this well Hugh Scott

Producing formation _____ Depth to top _____ Bottom _____ Total Depth of Well 4536 Feet

Show depth and thickness of all water, oil and gas formations.

OIL, GAS OR WATER RECORDS

CASING RECORD

FORMATION	CONTENT	FROM	TO	SIZE	PUT IN	PULLED OUT
				8-5/8"	296'	None
				4-1/2"	4534'	3478'

Describe in detail the manner in which the well was plugged, indicating where the mud fluid was placed and the method or methods used in introducing it into the hole. If cement or other plugs were used, state the character of same and depth placed, from _____ feet to _____ feet for each plug set.

Checked hole to 4300', pushed plug to 4320' and dumped 5 sacks of cement @ 4320' with dump bailer. Pulled 4 1/2" casing to 700' and pumped in 25 sacks of cement. Pulled 4 1/2" casing to 250' and pumped in 25 sacks of cement. Pulled balance of 4 1/2" casing, mudded to 50', set rock bridge to 40' and ran 15 sacks of cement to base of cellar.

RECEIVED
STATE CORPORATION COMMISSION

PLUGGING COMPLETE.

OCT 16 1963

CONSERVATION DIVISION

(If additional description is necessary, use BACK of this form)

Name of Plugging Contractor KNIGHT CASING PULLING COMPANY

Address CHASE, KANSAS

STATE OF KANSAS COUNTY OF RICE, ss.

Noel J. Knight (employee of owner) or (~~owner or operator~~) of the above-described well, being first duly sworn on oath, says: That I have knowledge of the facts, statements, and matters herein contained and the log of the above-described well as filed and that the same are true and correct. So help me God.

(Signature) Noel J. Knight
Chase, Kansas

(Address)

SUBSCRIBED AND SWORN TO before me this 5th day of October, 1963

Milton J. Volin

Notary Public.

My commission expires May 20, 1964

15.083.10308.00.00
WELL LOG

COMPANY **Schultz, Turner and Webb**

SEC. 17 T. 22S R. 22W
LOC. C/SW SE

FARM **Ewy "A"** NO. 2

RIG. NO. 4

TOTAL DEPTH **4536'**

COUNTRY **Hodgeman - Kansas**
KANSAS


COMM. **1-22-63**

COMP. **2-4-63**

SHOT OR TREATED

CONTRACTOR **Murfin Drilling Company**

ISSUED

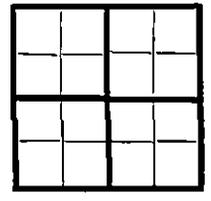

CASING

20 10
15 8 5/8" 296' w/200 sacks
12 6
13 5
4 1/2" 4534' w/150 sacks

ELEVATION

PRODUCTION **Oil**

FIGURES INDICATE BOTTOM OF FORMATIONS

- 40 Clay & Post Rock
- 70 Sand & Gravel
- 225 Shale
- 285 Blue Shale
- 700 Shale
- 1025 Shale & Sand
- 1175 Sand - Red Bed
- 1389 Shale
- 1425 Anhydrite
- 2000 Shale
- 2303 Shale & Lime
- 2705 Lime
- 3975 Lime & Shale
- 4095 Lime
- 4190 Lime & Shale
- 4445 Lime
- 4481 Lime & Chat
- 4534 Miss. Chert
- 4536 Total Depth

RECEIVED
STATE CORPORATION COMMISSION

SEP 23 1963

CONSERVATION DIVISION
Wichita, Kansas

State of Kansas
County of Sedgwick } ss:

I, Fred Murfin of the Murfin Drilling Company

upon oath state that the above and foregoing is a true and correct copy of the log of the Ewy "A" #2 well.

Fred Murfin
Fred Murfin By MKB

Subscribed and sworn to before me this 13th day of February 1963

My Commission Expires: ADELA MIZENER, Notary Public
My commission expires November 5, 1966

Adela Mizener
NOTARY PUBLIC