


STATE OF KANSAS
STATE CORPORATION COMMISSION

Give All Information Completely
Make Required Affidavit
Mail or Deliver Report to:
Conservation Division
State Corporation Commission
211 No. Broadway
Wichita, Kansas

15.083.10347.00.00
WELL PLUGGING RECORD

HODGEMAN County, Sec. 11 Twp. 22S Rge. 22 (EX W (W))

Location as "NE/CNW/SW" or footage from lines C-SE, SE
Lease Owner WILCOX OIL COMPANY & MOBIL OIL COMPANY
Lease Name EMMA Well No. 1
Office Address Box 1440, Tulsa, Oklahoma
Character of Well (completed as Oil, Gas or Dry Hole) Dry Hole
Date well completed December 29, 1962
Application for plugging filed December 29, 1962
Application for plugging approved December 29, 1962
Plugging commenced December 29, 1962
Plugging completed December 29, 1962
Reason for abandonment of well or producing formation No productible zone

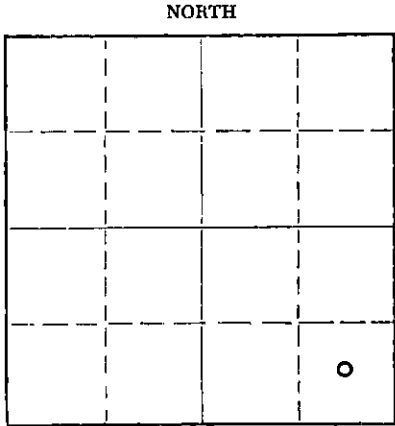

Locate well correctly on above Section Plat

If a producing well is abandoned, date of last production 19
Was permission obtained from the Conservation Division or its agents before plugging was commenced? Yes

Name of Conservation Agent who supervised plugging of this well Hugh E. Scott
Producing formation _____ Depth to top _____ Bottom _____ Total Depth of Well 4550 Feet
Show depth and thickness of all water, oil and gas formations.

OIL, GAS OR WATER RECORDS

CASING RECORD

FORMATION	CONTENT	FROM	TO	SIZE	PUT IN	PULLED OUT
				8-5/8"	266.53'	

Describe in detail the manner in which the well was plugged, indicating where the mud fluid was placed and the method or methods used in introducing it into the hole. If cement or other plugs were used, state the character of same and depth placed, from _____ feet to _____ feet for each plug set.

Gunned up pits forming heavy mud, filled hole up to 250 with heavy mud, pushed wooden plug to 250', capped with 35 sx. com. cement.
Filled hole up to 40' with heavy mud, pushed wooden plug to 40', filled to base of well cellar with 10 sx. com. cement.

STATE CORPORATION COMMISSION

JAN 24 1963

CONSERVATION DIVISION
Wichita, Kansas

(If additional description is necessary, use BACK of this sheet)

Name of Plugging Contractor Garvey Drilling Company
Address Route #2, Great Bend, Kansas

STATE OF Kansas, COUNTY OF Barton, ss.
Verne A. Morris (employee of owner) ~~XXXXXXXXXXXX~~ of the above-described well, being first duly sworn on oath, says: That I have knowledge of the facts, statements, and matters herein contained and the log of the above-described well as filed and that the same are true and correct. So help me God.

(Signature) Verne A. Morris
Route #2, Great Bend, Kansas
(Address)

SUBSCRIBED AND SWORN TO before me this 31st day of December, 1962

My commission expires October 24, 1966

Granfubury
Notary Public.

WELL LOG

15.083.10347.00.00

COMPANY WILCOX OIL COMPANY & MOBIL OIL COMPANY

SEC. 11 T. 22S R. 22W

FARM EMMA

NO. 1


LOC. C-SE, SE

TOTAL DEPTH 4550'

COUNTY HODGEMAN CO., KANSAS

COMM. December 14, 1962 COMP. December 29, 1962

CONTRACTOR GARVEY DRILLING COMPANY

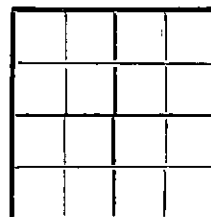

CASING 8-5/8" @ 266.53' w/200 sax.

ELEVATION

PRODUCTION D & A

FIGURES INDICATE BOTTOM OF FORMATIONS

44	Surface soil & clay
269	Clay & shale
600	Shale
820	Red bed & shale
1000	Sand
1358	Shale & shells
1402	Anhydrite
2305	Shale
2410	Lime & shale
2700	Lime
2930	Shale & lime
3455	Shale
3860	Shale & lime
4030	Lime & shale
4085	Lime
4272	Lime & shale
4550	Lime
4550	T. D.

RECEIVED
STATE CORPORATION COMMISSION

JAN 21 1963

CONSERVATION DIVISION
Wichita, Kansas

State of KANSAS }
County of BARTON } ss

I, VERNE A. MORRIS of GARVEY DRILLING COMPANY

upon oath state the above and foregoing is a true and correct copy of the log of the #1 EMMA well.

Subscribed and sworn to before me this 11th day of January 1963

My Commission Expires: October 24, 1966

Bransburg
NOTARY PUBLIC