


15.083.00064.00.00

STATE OF KANSAS
STATE CORPORATION COMMISSION

Give All Information Completely
Make Required Affidavit
Mail or Deliver Report to:
Conservation Division
State Corporation Commission
211 No. Broadway
Wichita, Kansas

WELL PLUGGING RECORD

Hodgeman County, Sec. 16 Twp 21 Rge. 26W (E) (W)
Location as "NE/CNW&SW&" or footage from lines C NE NE
Lease Owner Kern-Landes Exploration Co.
Lease Name Dumler Well No. 1
Office Address Box 107, Liberal, Kansas
Character of Well (completed as Oil, Gas or Dry Hole) _____
Date well completed July 20 1962
Application for plugging filed July 20 1962
Application for plugging approved July 20 1962
Plugging commenced July 20 1962
Plugging completed July 20 1962
Reason for abandonment of well or producing formation Dry Hole

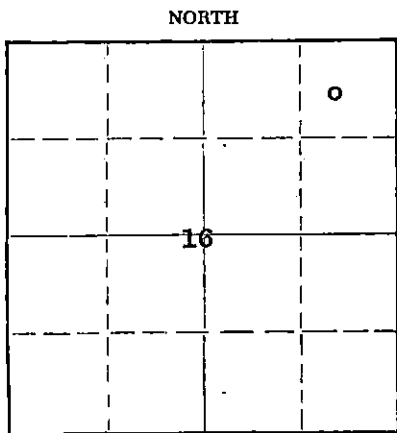

Locate well correctly on above
Section Plat

If a producing well is abandoned, date of last production _____ 19____
Was permission obtained from the Conservation Division or its agents before plugging was commenced? Yes

Name of Conservation Agent who supervised plugging of this well Hugh Scott, Box 1223, Liberal, Kansas
Producing formation _____ Depth to top _____ Bottom _____ Total Depth of Well _____ Feet
Show depth and thickness of all water, oil and gas formations.

OIL, GAS OR WATER RECORDS

CASING RECORD

FORMATION	CONTENT	FROM	TO	SIZE	PUT IN	PULLED OUT
		0	443'	8 / 58	443'	None

Describe in detail the manner in which the well was plugged, indicating where the mud fluid was placed and the method or methods used in introducing it into the hole. If cement or other plugs were used, state the character of same and depth placed, from _____ feet to _____ feet for each plug set.

Set Plug @ 420' 30 sacks cement & 1/4 sack hulls
Plug @ 50' 20 sacks cement & 1/4 sack hulls

RECEIVED
STATE CORPORATION COMMISSION
AUG 1 1962
CONSERVATION DIVISION
Wichita, Kansas

8-14-62

(If additional description is necessary, use BACK of this sheet)
Name of Plugging Contractor Hellar Drilling Company, Inc.
Address 1014 Union Center, Wichita, Kansas

STATE OF Kansas COUNTY OF Sedgwick, ss.
D. L. Hellar, Pres. of Hellar Drlg. Co. Inc. (employee of owner) or (owner or operator) of the above-described well, being first duly sworn on oath, says: That I have knowledge of the facts, statements, and matters herein contained and the log of the above-described well as filed and that the same are true and correct. So help me God.

(Signature) D. L. Hellar - President
1014 Union Center, Wichita, Kansas
(Address)

SUBSCRIBED AND SWORN TO before me this 10th day of August, 1962

My commission expires March 25, 1964.

Catherine Darcey
Catherine Darcey Notary Public.



DRILLER'S LOG

OWNER: Kern-Landes Exploration Co. Inc.
 CONTRACTOR: Hellar Drilling Company, Inc.
 LEASE: #1 Dumler
 LOCATION: c NE NE Section 16-21S-26W
 Hodgeman County, Kansas
 COMMENCED: July 4, 1962
 COMPLETED: July 20, 1962
 CASING: Set 8 5/8" surface casing @ 443'
 /275 sacks cement.

0-1032	Shale, Sand & Red Bed
1032-1088	Red Bed
1088-1099	Blaine
1099-1615	Red Bed, Sand & Shale
1615-1685	Red Bed, Shale
1685-1725	Cimmaron-Anhydrite
1725-2085	Red Bed, Shale
2085-2329	Shale, Shells & Salt
2329-2471	Ft. Riley
2471-2621	Shale & Lime
2621-2920	Lime & Shale
2920-2980	Lime chalky & shale
2980-3338	Lime & Shale stks.
3338-3837	Shale & Lime
3837-3946	Lansing-Kansas City
3946-3999	Lime
3999-4120	Lansing-Kansas City
4120-4173	Lime
4173-4272	Lansing-Kansas City
4272-4327	Lime & Shale
4327-4359	Marmaton
4359-4463	Lime & Shale
4463-4478	Cherokee
4478-4515 1/2	Ream (4478-4515 1/2 Core #1)
4515 1/2-4588	Core Rat Hole (4515 1/2-4588 Core #2)
4588-4563	Mississian
4563	Total Rotary Depth
	D & A

RECEIVED
STATE CORPORATION COMMISSION

JUL 27 1962

CONSERVATION DIVISION
Wichita, Kansas

STATE OF KANSAS)
) SS
 COUNTY OF SEDGWICK)

I, D. L. Hellar, do hereby certify that the above and foregoing is a true and correct copy of the log of the #1 Dumler, located in the c NE NE of Section 16-21S-6W, Hodgeman County, Kansas, as reflected by the files of the Hellar Drilling Company, Inc.

HELLAR DRILLING COMPANY, INC.

By *D. L. Hellar*
 D. L. Hellar, President

Subscribed and sworn to before me, a Notary Public, in and for Sedgwick County, Kansas, this 25th day of July, 1962.

Catherine Darcey
 Notary Public - Catherine Darcey

My Commission Expires:
 March 25, 1964.