


Give All Information Completely
Make Required Affidavit
Mail or Deliver Report to:
Conservation Division
State Corporation Commission
212 No. Market
Wichita, Kansas

WELL PLUGGING RECORD

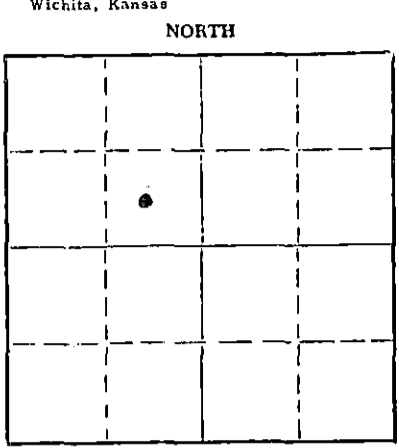

Locate well correctly on above Section Plat

Finney County, Sec. 6 Twp. 22S Rge. (E) 33 (W)
Location as "NE/CNWxSWx" or footage from lines C SE NW
Lease Owner Anadarko Production Company
Lease Name Maune "A" Well No. 1
Office Address Box 351 Liberal, Kansas 67901
Character of Well (completed as Oil, Gas or Dry Hole) Dry Hole
Date well completed 8-20 1972
Application for plugging filed 8-29 1972
Application for plugging approved Verbal approval received 8-20 1972
Plugging commenced 8-20 1972
Plugging completed 8-20 1972
Reason for abandonment of well or producing formation

If a producing well is abandoned, date of last production 19
Was permission obtained from the Conservation Division or its agents before plugging was commenced? Yes

Name of Conservation Agent who supervised plugging of this well Mr. Ed Eves Box "F" Sublette, Kansas 67877
Producing formation Depth to top Bottom Total Depth of Well 484.1 Feet
Show depth and thickness of all water, oil and gas formations.

OIL, GAS OR WATER RECORDS

CASING RECORD

FORMATION	CONTENT	FROM	TO	SIZE	PUT IN	PULLED OUT
				8 5/8	979'	NONE

Describe in detail the manner in which the well was plugged, indicating where the mud fluid was placed and the method or methods used in introducing it into the hole. If cement or other plugs were used, state the character of same and depth placed, from feet to feet for each plug set.

Spotted 35 sxs. cement 940' to 840'.

Spotted 15 sxs. cement 40' to surface.

RECEIVED
STATE CORPORATION COMMISSION
SEP 1 1972
CONSERVATION DIVISION
Wichita, Kansas

(If additional description is necessary, use BACK of this sheet)
Name of Plugging Contractor Garvey Drilling Company
Address Great Bend, Kansas

STATE OF KANSAS, COUNTY OF SEWARD, ss.
W. A. BEATTY (employee of owner) or (owner or operator) of the above-described

Wells being best duly sworn on oath, says: That I have knowledge of the facts, statements, and matters herein contained and the log of the above-described well as filed and that the same are true and correct. So help me God.


(Signature) W.A. Beatty
W.A. BEATTY Division Production Manager
Box 351 Liberal, Kansas 67901
(Address)

SUBSCRIBED AND SWORN to before me this 21st day of August 1972

My Commission Expires September 9, 1972

My commission expires

[Signature]
Notary Public.

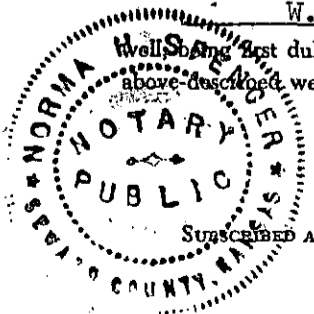

DRILLER'S LOG

WELL NAME Maune "A" No. 1 COMPANY OPERATING Anadarko Production Company
 ADDRESS OF COMPANY Box 351 Liberal, Kansas 67901
 WELL LOCATION C $\frac{1}{4}$ SE $\frac{1}{4}$ NW $\frac{1}{4}$
Ft. North of South Line,
Ft. East of West Line, Sec. 6, Twp. 22S, Rge. 33W, Finney County, Kansas

DRILLING STARTED 8-8, 19 72, DRILLING COMPLETED 8-20, 19 72
 WELL COMPLETED 8-20, 19 72, WELL CONNECTED _____, 19 _____

ELEVATION 2900.0 Ft. Ground Level CHARACTER of WELL (Oil, Gas, Dry Hole) Dry Hole

OIL OR GAS SANDS OR ZONES - PERFORATIONS - ACIDIZING AND FRACTURING INFORMATION					
Name	From	To	No. of Shots	Gallons Used	Kind Used

RECEIVED
 STATE CORPORATION COMMISSION
 SEP 1 1972
 CONSERVATION DIVISION
 Wichita, Kansas

CASING RECORD

Size	Amount Set	Sacks of Cement	Amount Pulled
8 5/8	979'	550	NONE

FORMATION RECORD

Formation	Top	Bottom	Formation	Top	Bottom
Clay & Sand	0	115			
Shale & Sand	115	989			
Shale & Red Bed	989	1045			
Red Bed & Shale	1045	1526			
Sand	1526	1650			
Shale & Red Bed	1650	2000			
Shale & Shells	2000	2025			
Shale	2025	2534			
Shale & Lime	2534	2954			
Lime & Shale	2954	3780			
Lime	3780	4841			
TOTAL DEPTH	4841				

RESULTS OF INITIAL PRODUCTION TEST: D & A