


STATE OF KANSAS
STATE CORPORATION COMMISSION

WELL PLUGGING RECORD

Give All Information Completely
Make Required Affidavit
Mail or Deliver Report to
Conservation Division
State Corporation Comm.
245 North Water
Wichita, KS 67202

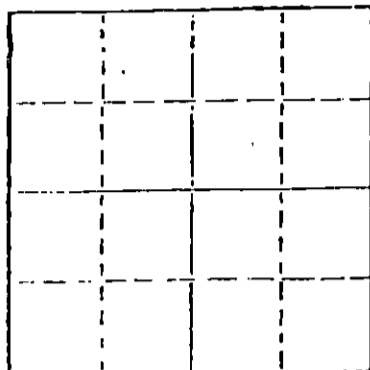

Locate well correctly on above
Section Plat

Hodgeman County, Sec. 8 Twp. 27 Rge. 23 E (W)
Location as "NE/CNW $\frac{1}{4}$ SW $\frac{1}{4}$ " or footage from lines

NW SE SE
Lease Owner Wil-Mc Oil Corp. (El Gato Drlg. Co.)
Lease Name Rehmart Well No. 1
Office Address 3950 1st International Bldg., Dallas Tx
Character of Well (Completed as Oil, Gas or Dry Hole) 75270
dry hole

Date Well completed 5-8-1980
Application for plugging filed 5-8-1980
Application for plugging approved 5-8-1980
Plugging commenced 5-8-1980
Plugging completed 5-8-1980
Reason for abandonment of well or producing formation
no commercial quantity of oil or gas encountered
If a producing well is abandoned, date of last production -- 19

Was permission obtained from the Conservation Division or
its agents before plugging was commenced? yes

Name of Conservation Agent who supervised plugging of this well Clarence Thomas
Producing formation Depth to top Bottom Total Depth of Well 4694
Show depth and thickness of all water, oil and gas formations.

OIL, GAS OR WATER RECORDS

CASING RECORD

FORMATION	CONTENT	FROM	TO	SIZE	PUT IN	PULLED OUT
surface hole	shale	surf	430'	8-5/8"	422	none

Describe in detail the manner in which the well was plugged, indicating where the mud fluid
was placed and the method or methods used in introducing it into the hold. If cement or other
plugs were used, state the character of same and depth placed, from feet to
feet for each plug set.

Fluid to 900', plug, 60 sx
Fluid to 430', plug, 35 sx
Fluid to 40', plug, 10 sacks
Rat hole 5 sx

(If additional description is necessary, use BACK of this sheet)

Name of Plugging Contractor DNR DRILLING, INC.

Wichita, Kansas 67202

STATE OF Kansas COUNTY OF Sedgwick, ss.
Ella Priess (employee of owner) or (owner or operator)
of the above-described well, being first duly sworn on oath, says: That I have knowledge of
the facts, statements, and matters herein contained and the log of the above-described well
as filed and that the same are true and correct. So help me God.

(Signature)

Ella Priess

515 R.H. Garvey Bldg., Wichita, Ks. 67230
(Address)

SUBSCRIBED AND SWORN TO before me this 9th day of May, 19 80

RECEIVED
STATE CORPORATION COMMISSION

Dorothy L. Schmidt
Dorothy L. Schmidt Notary Public.

My commission expires April 30, 1983

MAY 16 1980

CONSERVATION DIVISION
Wichita, Kansas

DOROTHY L. SCHMIDT
STATE NOTARY PUBLIC
Sedgwick County, Kansas
My Appt. Exp. April 30, 1983

5-16-80

DRILLER'S LOG

Wil-Mc Oil Corporation
No. 1 Rehmart
NW SE SE
Sec. 8-22S-23W
Hodgeman Co., Ks.

Commenced: 4-29-80
Completed: 5-8-80

Surface Casing: 422' of 8-5/8"
cemented w/275' sx common, 2% gel, 3%cc
4-29-80

FORMATION

DEPTH

Surface Hole	0 - 430
Shale & Sand	430 - 1040
Blaine	1040 - 1052
Shale, Sand & Red Bed	1052 - 1265
Sand & Shale	1265 - 1760
Shale & Lime	1760 - 2005
Shale	2005 - 2395
Shale & Lime	2395 - 2835
Lime & Shale	2835 - 4010
Lime	4010 - 4375
Lime & Shale	4375 - 4525
Lime	4525 - 4694 RTD

I do hereby certify that the foregoing statements are true and correct to the best of my knowledge and belief.

D N B DRILLING, INC.

Ella Priess

Ella Priess

STATE OF KANSAS: ss:

Subscribed and sworn to before me this 8th day of May, 1980.

Dorothy L. Schmidt

Dorothy L. Schmidt, Notary Public

RECEIVED
STATE CORPORATION COMMISSION

MAY 16 1980

CONSERVATION DIVISION
Wichita, Kansas

DOROTHY L. SCHMIDT
STATE NOTARY PUBLIC
Sedgwick County, Kansas
My Appt. Exp. April 30, 1983