


STATE OF KANSAS  
STATE CORPORATION COMMISSION

Give All Information Completely  
Make Required Affidavit  
Mail or Deliver Report to  
Conservation Division  
State Corporation Commission  
P. O. Box 17027  
Wichita, Kansas 67217  
NORTH

## WELL PLUGGING RECORD

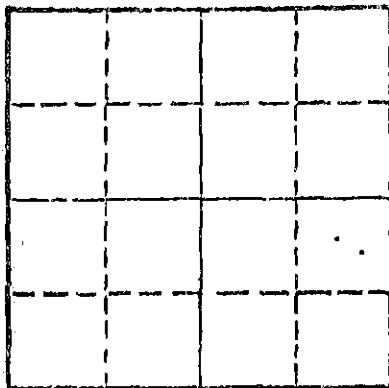

Locate well correctly on above  
Section Plat

Hodgeman County, Sec. 7 Twp. 22S Rge. 23W (XX) (XX)  
Location as "NE/CNWSW4" or footage from lines SE NW  
Lease Owner Francis Oil & Gas, Inc.  
Lease Name Goebel Well No. 1  
Office Address 4120 East 51st. Street, Tulsa, Okla. 74135  
Character of Well (completed as Oil, Gas or Dry Hole) Dry Hole  
Date well completed November 27, 1973  
Application for plugging filed Verbal Application 19  
Application for plugging approved Verbal Approval 19  
Plugging commenced November 27, 1973  
Plugging completed November 27, 1973  
Reason for abandonment of well or producing formation

If a producing well is abandoned, date of last production 19  
Was permission obtained from the Conservation Division or its agents before plugging was commenced? Yes

Name of Conservation Agent who supervised plugging of this well Edgar J. Eves  
Producing formation Depth to top Bottom Total Depth of Well 4,130 Feet  
Show depth and thickness of all water, oil and gas formations.

## OIL, GAS OR WATER RECORDS

## CASING RECORD

FORMATION	CONTENT	FROM	TO	SIZE	PUT IN	PULLED OUT
				8-5/8"	564'	None

Describe in detail the manner in which the well was plugged, indicating where the mud fluid was placed and the method or methods used in introducing it into the hole. If cement or other plugs were used, state the character of same and depth placed, from feet to feet for each plug set.

Filled hole with heavy rotary mud from 4,130 feet (rotary total depth) to 800 feet. Set plug at 800 feet and cemented with 35 sacks cement. Filled hole with heavy rotary mud from 800 feet to 560 feet. Set plug at 560 feet and cemented with 35 sacks cement. Filled hole with heavy rotary mud from 560 feet to 40 feet. Set solid plug at 40 feet and cemented to cellar with 15 sacks cement, 2 sacks cement in rat hole. Plugging operations accomplished utilizing Halliburton Oil Well Cementing pump truck through 4 1/2 inch drill pipe.

RECEIVED  
STATE CORPORATION COMMISSION

NOV 30 1973

CONSERVATION DIVISION  
Wichita, Kansas

(If additional description is necessary, use BACK of this sheet)  
Name of Plugging Contractor H-30, Inc. 11-30-73  
Address 200 North Main, Wichita, Kansas 67202

STATE OF Kansas, COUNTY OF Sedgwick  
Dean Britting, Agent (Signed by owner) of the above-described well, being first duly sworn on oath, says: That I have knowledge of the facts, statements, and matters herein contained and the log of the above-described well as filed and that the same are true and correct. So help me God.

(Signature) Dean Britting  
200 No. Main, Wichita, Kansas 67202  
(Address)

Subscribed and Sworn to before me this 29th day of November, 1973

Elsie Willison  
Notary Public.

June 30, 1974



KANSAS GEOLOGICAL SOCIETY  
KANSAS WELL LOG BUREAU - KANSAS WELL SAMPLE BUREAU  
KANSAS GEOLOGICAL SOCIETY BUILDING  
508 EAST MURDOCK - WICHITA, KANSAS

15-083.20334-0000

COMPANY Francis Oil & Gas, Inc.

SEC. 7 T. 22S R. 23W  
LOC. SE NW

FARM Goebel

NO. 1

TOTAL DEPTH 4,130'

COMM. November 19, 1973

COMP. November 27, 1973

SHOT OR TREATED

CONTRACTOR H-30, Inc.

ISSUED

COUNTY Hodgeman

KANSAS

CASING

20

10

15

12

13

8

6

5

5 7/8" 564' cemented w/300 sxs cement ELEVATION 2,419 KB

PRODUCTION

FIGURES INDICATE BOTTOM OF FORMATIONS

Clay, Post Rock and Shale	520'
Shale	710'
Shale, Shells and Red Bed	1,078'
Blaine Gypsum	1,095'
Red Bed and Shale	1,105'
Shale and Shells	1,545'
Shale	1,708'
Anhydrite	1,723'
Shale	1,890'
Red Bed, Shale and Lime	2,325'
Shale and Lime	3,020'
Lime and Shale	3,312'
Shale and Lime	3,380'
Lime and Shale	3,699'
Shale and Lime	3,795'
Lime and Shale	3,930'
Lime	4,130'
Rotary Total Depth	4,130'

RECEIVED  
STATE CORPORATION COMMISSION  
NOV 30 1973  
CONSERVATION DIVISION  
Wichita, Kansas

I hereby certify the above and foregoing  
to be a true and correct log of the above  
described well as shown by the drilling  
reports.

H-30, INC.

Dean Britting  
Dean Britting

State of Kansas

County of Sedgwick

ss:

Subscribed and Sworn to before me a Notary  
Public in and for said county and state  
this 29th. day of November, 1973.

Elsie Willison  
Elsie Willison - Notary Public

My Commission Expires:

June 30, 1974