

STATE OF KANSAS  
STATE CORPORATION COMMISSION

Form CP-4

WELL PLUGGING RECORD

Give All Information Completely  
Make Required Affidavit  
Mail or Deliver Report to:  
Conservation Division  
State Corporation Commission  
211 No. Broadway  
Wichita, Kansas

Hodgeman County, Sec. 28 Twp. 22 Rge.      (E) 22 (W)

Location as "NE/CNWxSWx" or footage from lines 6 NE NE

Lease Owner James W. Hershberger

Lease Name Miller Well No. 1

Office Address 1039 First National Bank Bldg., Wichita, Kansas

Character of Well (completed as Oil, Gas or Dry Hole) Dry Hole

Date well completed 10/4/63 19  

Application for plugging filed 10/4/63 19  

Application for plugging approved 10/4/63 19  


Plugging commenced 10/4/63 19  

Plugging completed 10/4/63 19  

Reason for abandonment of well or producing formation Dry Hole, No casing Run

If a producing well is abandoned, date of last production      19  

Was permission obtained from the Conservation Division or its agents before plugging was commenced? Yes

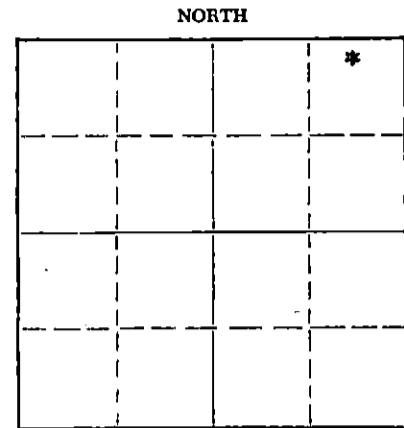

Locate well correctly on above Section Plat

Name of Conservation Agent who supervised plugging of this well Hugh E. Scott

Producing formation Dry Hole Depth to top      Bottom      Total Depth of Well 4485 Feet

Show depth and thickness of all water, oil and gas formations.

OIL, GAS OR WATER RECORDS

CASING RECORD

FORMATION	CONTENT	FROM	TO	SIZE	PUT IN	PULLED OUT
Lansing	Water	3846	4185	8 5/8	200	none
Mississippi	Water	4455	4485			

Describe in detail the manner in which the well was plugged, indicating where the mud fluid was placed and the method or methods used in introducing it into the hole. If cement or other plugs were used, state the character of same and depth placed, from 700 feet to surface feet for each plug set.

- Plug # 1 700' W/ 25 SX plus 1/4 SX hulls
- Plug #2 250' W/ 25 SX plus 1/4 SX hulls
- Plug # 3 40' W/ 15 SX plus 1/4 SX hulls

10-14-63

RECEIVED  
STATE CORPORATION COMMISSION

OCT 14 1963

CONSERVATION DIVISION  
Wichita, Kansas

(If additional description is necessary, use BACK of this sheet)  
Name of Plugging Contractor Rotary Hole, No Casing Set  
Address     

STATE OF Florida, COUNTY OF Dade, ss.

(employee of owner) or (owner or operator) of the above-described well, being first duly sworn on oath, says: That I have knowledge of the facts, statements, and matters herein contained and the log of the above-described well as filed and that the same are true and correct. So help me God.

(Signature) Joseph Reichman, Jr. - Shalom Drilling Co. Inc.  
2451 Brickell Ave. Miami, Fla.  
(Address)

SUBSCRIBED AND SWORN TO before me this 10 day of October 1963

My commission expires       
NOTARY PUBLIC STATE OF FLORIDA at LARGE  
MY COMMISSION EXPIRES JUNE 3, 1966  
BONDED THROUGH FRED W. DIESTELHORST

Notary Public.

15-083-10060-0000

SHOLOM DRILLING COMPANY, INC.  
P. O. Box 7027  
Tulsa, Oklahoma

SHOLOM DRILLING CO., INC.  
2451 BRICKELL AVENUE  
MIAMI, FLORIDA

COMPANY: JAMES W. HERSHBERGER  
FARM: MILLER # 1  
LOCATION: SEC. 28 T 22 S R22W - HODGEMAN COUNTY, KANSAS  
ROTARY DRILLING CONTRACTOR: SHOLOM DRILLING COMPANY, INC.

COMMENCED: 9/21/63  
COMPLETED: 10/4/63  
I. P.: D & A

Elevation: 2207 KB  
Rotary TD: 4485'

Casing Record:  
8-5/8" @ 260' w/175 sax

L O G

0 - 105 Clay and Sand  
105 - 490 Shale & Shells  
490 - 825 Red Bed  
825 - 995 Sand  
995 - 1025 Shale & Shells w/ Sand Streaks  
1025 - 1344 Red Bed - Shale & Shells  
1344 - 1381 Anhydrite  
1381 - 1450 Shale & Shells  
1450 - 1780 Shale  
1780 - 2120 Shale & Shells  
2120 - 2675 Lime  
2675 - 3913 Lime and Shale  
3913 - 4428 Shale & Lime  
4428 - 4455 Shale & Lime  
4455-- 4485 Mississippi Chert

Ran Schlumberger at T.D.  
DST # 1 4395-4465  
Rec. 20' Mud  
  
DST # 2 4463-85  
Rec. 2380' Water

RECEIVED  
STATE CORPORATION COMMISSION  
OCT 14 1963  
CONSERVATION DIVISION  
Wichita, Kansas

STATE OF FLORIDA)  
                                  ) ss.  
COUNTY OF DADE )

I, Joseph Teichman, President of Sholom Drilling Company, Inc.  
a corporation of the state of Oklahoma, domesticated in the State of  
Kansas, being first duly sworn under oath, says: That I have knowledge  
of the facts, statements, and matters herein contained of the above  
described well as filed and that the same are true and correct.

*Joseph Teichman*  
\_\_\_\_\_  
Joseph Teichman

Subscribed and sworn to before me this 8th day of October, 1963.

My Commission expires : \_\_\_\_\_

NOTARY PUBLIC STATE OF FLORIDA at LARGE  
MY COMMISSION EXPIRES JUNE 3, 1966  
BONDED THROUGH FRED W. DIESTELHORST

*J. H. Moran*  
\_\_\_\_\_  
Notary Public