


STATE OF KANSAS  
STATE CORPORATION COMMISSION

WELL PLUGGING RECORD

Give All Information Completely  
Make Required Affidavit  
Mail or Deliver Report to:  
Conservation Division  
State Corporation Commission  
212 No. Market  
Wichita, Kansas

Hodgeman County, Sec. 28 Twp. 22S Rge. (E) 22(W)

Location as "NE/CNW/SW" or footage from lines Ctr. SE NW  
Lease Owner Graybol Oil Corporation  
Lease Name Schnetzer Well No. 1  
Office Address 607 National Bank of Tulsa Bldg., Tulsa, Oklahoma 74103  
Character of Well (completed as Oil, Gas or Dry Hole) Dry Hole  
Date well completed July 25 19 68  
Application for plugging filed July 25 19 68  
Application for plugging approved July 25 19 68  
Plugging commenced July 25 19 68  
Plugging completed July 25 19 68  
Reason for abandonment of well or producing formation

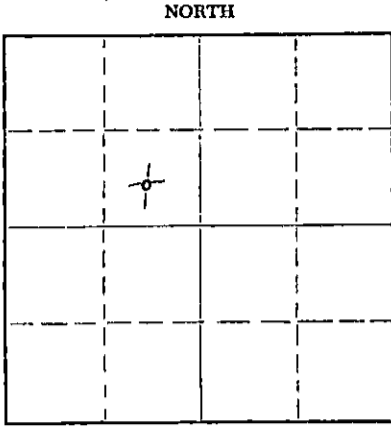

Locate well correctly on above Section Plat

If a producing well is abandoned, date of last production 19  
Was permission obtained from the Conservation Division or its agents before plugging was commenced? yes

Name of Conservation Agent who supervised plugging of this well Bill Grannell Sublette, Kansas 67877  
Producing formation None Depth to top Bottom Total Depth of Well 4510 Feet  
Show depth and thickness of all water, oil and gas formations.

OIL, GAS OR WATER RECORDS

CASING RECORD

FORMATION	CONTENT	FROM	TO	SIZE	PUT IN	PULLED OUT
Lansing	Impermeable	3864	4171	8 5/8"	288'	None
Mississippian	Water	4494	4510			

Describe in detail the manner in which the well was plugged, indicating where the mud fluid was placed and the method or methods used in introducing it into the hole. If cement or other plugs were used, state the character of same and depth placed, from feet to feet for each plug set.

Filled hole with heavy mud-laden fluid to 850'. Put in 100 sacks of Portland cement. Filled hole with heavy mud-laden fluid to 300'. Put in 35 sacks of Portland cement. Filled hole with heavy mud-laden fluid to 35'. Inserted Halliburton plug and a sack of hulls. Put in ten sacks of Portland cement, filling hole to surface. Cementing done with Halliburton cement truck.

RECEIVED  
STATE CORPORATION COMMISSION  
JUL 29 1968  
CONSERVATION DIVISION  
Wichita, Kansas

(If additional description is necessary, use BACK of this sheet)

Name of Plugging Contractor  
Address

STATE OF OKLAHOMA, COUNTY OF TULSA, ss.  
Lyman C. Dennis (employee of owner) or (owner or operator) of the above-described well, being first duly sworn on oath, says: That I have knowledge of the facts, statements, and matters herein contained and the log of the above-described well as filed and that the same are true and correct. So help me God.

(Signature) Lyman C. Dennis  
Tulsa, Oklahoma (Address)

SUBSCRIBED AND SWORN to before me this 26th day of July, 19 68

Nancy Lu Ray Notary Public.

My commission expires September 14, 1970

GRAYBOL OIL CORPORATION

Hodgeman County, Kansas

No. 1 Schmetzer

Ctr. SE NW Section 28-22S-22W

Contractor: Company Tools

Elev. 2230 DF &amp; KB, 2224 GL

Commenced: July 9, 1968

Completed: July 25, 1968

Production: Dry and Abandoned

## CASING RECORD

8 5/8" surface casing set at 288' with 165 sacks posmix cement.

DRILLER'S LOG

<u>DEPTH</u>	<u>FORMATION</u>	<u>SAMPLE TOPS</u>	
0-70	Surface clay	Stone Corral anhydrite	1370 (+ 860)
70-288	Sand and shale	Topeka limestone	3603 (-1373)
288-433	Blue shale	Heebner shale	3805 (-1575)
433-619	Shale	Lansing limestone	3864 (-1634)
619-820	Red bed	Base of Kansas City	4171 (-1941)
820-960	Sand	Cherokee	4392 (-2162)
960-1010	Shale	Mississippi Osage	4494 (-2264)
1010-1370	Red bed and shale		
1370-1395	Anhydrite		
1395-1715	Red bed, shale and shells		
1715-1995	Shale and shells		
1995-2220	Shale and lime streaks	No cores or drill stem tests taken.	
2220-2610	Shale and lime	No electric log run.	
2610-3090	Lime and shale		
3090-3260	Shale and lime		
3260-3395	Lime and shale		
3395-3480	Shale and lime		
3480-3835	Lime and shale		
3835-4360	Lime		
4360-4420	Lime and shale		
4420-4445	Shale and lime		
4445-4500	Lime and shale		
4500-4510	Lime and chert		
4510	Total Depth		

RECEIVED  
STATE CORPORATION COMMISSION  
JUL 29 1968  
CONSERVATION DIVISION  
Wichita, Kansas

I hereby certify that the above is a true and accurate log of the above-captioned test as taken directly from the daily drilling reports.

GRAYBOL OIL CORPORATION

BY: Lyman C. Dennis  
Lyman C. Dennis, Geologist

STATE OF OKLAHOMA

COUNTY OF TULSA

Subscribed and sworn to before me this 26th day of July, 1968.My commission expires: September 14, 1970

Nancy Lu Ray  
NOTARY PUBLIC